

**SURVEY &
REMONUMENTATION**

DEC 07 1994

RECEIVED FOR RECORD

94 OCT 12 PM 2:25

**RATIFIED BY PEER GROUP
PA 345 OF 1990
MONROE COUNTY, MICHIGAN**

date: 8/19/94
County Rep.: [Signature]

**COMMISSION
LAND CORNER RECORDATION CERTIFICATE
Filing Requirement of Act 74, Mich. P.A. 1970**

Heri Allen
REGISTER OF DEEDS
MONROE COUNTY, MICH

For corners in

<u>MONROE</u> (County)	Located In:	Corner Code #/
	IDA TWP.	
1. Public Land Survey	T <u>7</u> S R <u>7</u> E	G-6
	T _____ R _____	_____
	T _____ R _____	_____
	T _____ R _____	_____
2. Property Controlling in Section	S _____ T _____ R _____	_____
	S _____ T _____ R _____	_____
3. Miscellaneous Property in Sec.	S _____ T _____ R _____	_____
	S _____ T _____ R _____	_____

Register of Deeds Stamp & File Number

4. Lot No. _____, Recorded Plat _____
5. Private Claims _____

1994 MONROE COUNTY REMONUMENTATION PROGRAM

Peer Group approved corner on 8/9/1994 per Act 345 of 1990.

	A	B	C	D	E	F	G	H	I	J	K	L	M
2		6		5		4		3		2		1	
3													
4		7		8		9		10		11		12	
5													
6		18		17		16	●	15		14		13	
7													
8		19		20		21		22		23		24	
9													
10		30		29		28		27		26		25	
11													
12		31		32		33		34		35		36	
13													

I, G.B. WARNKE, JR., in a field survey on AUGUST 19, 1994, 19____, do hereby certify that under requirements of P.A. 74, Michigan P.A. of 1970, the corner points mentioned in lines 1 and 2 above were in conformance with regulations and rules therefore as required in the current manual of survey instructions of the United States Department of the Interior, Bureau of Land Management or by a decree of a Court of Law and/or that the corner points mentioned in lines 3, 4 and 5 above were in conformance with the rules of the Michigan Board of Land Surveyors or by a Decree of a Court of Law; established, re-established, monumented, re-monumented, recovered, found as expressed below:

NOTE: Not more than 4 corners, all in the same town and range, may be recorded on this certificate.

A. Description of original monument and accessories and/or subsequent restoration:


G-6, T7S, R7E, 1/4 Corner Common to Sections 15 & 16
(Jackman Road, 1/2 south of Ida Center Road - gravel over yellow sand)
G.L.O. Surveyor Joseph Wampler in 1820 set quarter section post and witnessed B.Oak 26 inch S89°W 41 links and B.Oak 16 inch N51°E 29 links. Old notes in small books indicates "no stone found". 1977, G.B. Warnke recorded in L.C.R.C., Liber 2, Page 199, to found iron pipe and used this point in the 1970's & 1980's.

B. Description of corner evidence found and/or method applied in restoring or reestablishing corner:

G-6 - 8/1/1994 - Found 1/2 inch x 30 inch iron pipe 12 inches deep. Excavated 2 foot deep x 3 foot diameter hole no further evidence found. It appears that someone earlier excavated for corner evidence. It is thought that post or stone would have been graded out due to evidence of yellow sand; road bed is approximately 18 inches below grade of hill. Who set 1/2 inch x 30 inch iron pipe? 8/19/1994, set 1 inch x 36 inch black iron pipe with brass remonumentation cap in place of 1/2 inch iron pipe. Witnessed as shown below.

C. Description of monument for corner and accessories established to perpetuate locating the position of the corner:

G-6 - Set 1 inch x 36 inch black iron pipe with brass remonumentation cap in place of 1/2 inch iron pipe and is accepted as the best available evidence of the position of the original corner and Witnesses:
North 80° West 23.67 feet found double head nail/washer east face 40 inch Oak
North 90° East 33.00 feet found capped iron No. 19474
North 30° East 58.19 feet set nail/shiner south face 12 inch twin Mulberry
North 65° East 17.51 feet set nail/shiner west face 15 inch Hickory tree

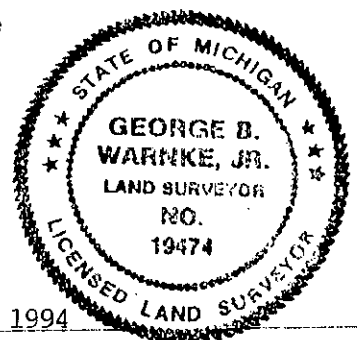

Signed by [Signature]
Surveyor's Michigan License No. 19474

Date AUGUST 19, 1994