

RATIFIED BY PEER GROUP
 PA 345 OF 1990
 MONROE COUNTY, MICHIGAN
 date: 8/29/95
 County Rep.: [Signature]

LAND CORNER RECORDATION CERTIFICATE
 Filing Requirement of Act 74, Mich. P.A. 1970

RECEIVED FOR RECORDS
 95 DEC 28 AM 9:00
 REGISTERED OF DEEDS
 MONROE COUNTY, MICH

For corners in

<u>Monroe</u> (County)	Located In:	Corner Code #
1. Public Land Survey Ida Twp.	T <u> </u> R <u> </u> T <u>7S</u> R <u>7E</u> T <u> </u> R <u> </u> T <u> </u> R <u> </u>	<u>I-1</u> <u> </u> <u> </u>
2. Property Controlling in Section	S <u> </u> T <u> </u> R <u> </u> S <u> </u> T <u> </u> R <u> </u>	<u> </u> <u> </u> SURVEY & REMONUMENTATION
3. Miscellaneous Property in Sec.	S <u> </u> T <u> </u> R <u> </u> S <u> </u> T <u> </u> R <u> </u>	<u> </u> <u> </u>

APR 04 1996

Register of Deeds Stamp & File Number

4. Lot No. _____, Recorded Plat _____
 5. Private Claims _____ **COMMISSION**

G.B.Wamke & Monroe Co. Road Commission Corner
 Bruce Antcliff 12/22 95
 I, G.B.Wamke, in a field survey on 10/04, 1995 do hereby state that under requirements of P.A. 74, Michigan P.A. of 1970, the corner points mentioned in lines 1 and 2 above were in conformance with regulations and rules therefore as required in the current manual of survey instructions of the United States Department of the Interior, Bureau of Land Management or by a decree of a Court of Law and /or that the corner points mentioned in lines 3, 4 and 5 above were in conformance with the rules of the Michigan Board of Land Surveyors or by a Decree of a Court of Law; established, re-established, monumented, recovered, found as expressed below.

NOTE: Not more than 2 corners, all in the same town and range, may be recorded on this certificate.

A	B	C	D	E	F	G	H	I	J	K	L	M
1												
2	6		5		4		3		2		1	
3												
4	7		8		9		10		11		12	
5												
6	18		17		16		15		14		13	
7												
8	19		20		21		22		23		24	
9												
10	30		29		28		27		26		25	
11												
12	31		32		33		34		35		36	
13												

A. Description of original monument and accessories and/or subsequent restoration:

Section corner common to Sections 2 & 3 / Ida East Rd. & Lewis Ave., Asphalt surface. 1820, GLO Surveyor J.Wampler / Orange Risdon intersect north boundary 19 links east of post / set post at intersection corner of sections 2 & 3 - witnesses: Elm 16 S60E 36 & Elm 19 S71W 1.26. 1893, Van Akins Plat by Willis Baldwin notes stone. 1929, O.A. Case used point on Witt Place Plat, material not noted. 1947 to 1980, A.J. Marino used corner several times not noting material, including Westwood Heights, Liber 12 of Plats, Page 38; 1978 he notes 3 different points in area - "Fnd PK, Fnd RRS, & Fnd I. Pipe - NW Corner Section 2". 1980 he notes "FIP (NE cor. Sec. 3 as reproduced from Van Akins plat)" & "PL. PK w/roof cap (NE Cor. Sec. 3 as reproduced from Wolf Plat & Peters-Lester Addition)". 1974, Glenn Richards recorded LCRC Liber 1, Page 462-463 to railroad spike in pavement. 1982, G.B.Wamke notes Fd. RR Spike per LCRC and notes other points in area. 1988, W.J.Zbikowski recorded LCRC Liber 3, Page 39 to "Found PK Nail".


B. Description of corner evidence found and/or method applied in restoring or reestablishing corner:

10/4/94, set concrete nail with shiner by re-establishing point using previous witnesses to railroad spike. All previous evidence of corner destroyed during construction in the area.
 12/22/95, checked point to verify that it is on the township line.

C. Description of monument for corner and accessories established to perpetuate locating the position of the corner:

Set 1 inch x 36 inch iron pipe with brass remonumentation cap inside monument box to replace concrete nail and is accepted as the best available evidence of the position of the original corner.

- Witnesses:
 North 52° East 41.11 feet to nail/shiner in SW face of util. Pole.
 North 25° West 96.94 feet to ESE corner of funeral home.
 South 39° West 99.05 feet to NE corner of block building, metal edge.
 South 32° West 52.92 feet to PK nail/shiner in NE face of light pole.
 South 27° East 49.68 feet to PK nail/shiner in NW face of guy pole.
 West 11.30 feet to I-13, T6S, R7E, brass remon cap in mon box.

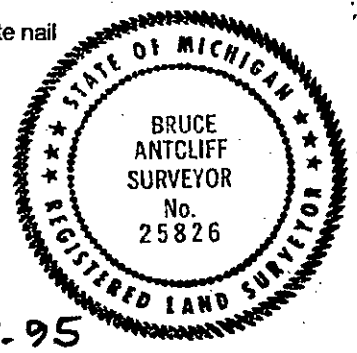

Signed by Bruce Antcliff
 Surveyor's Michigan License No. 25826

Date 12-27-95

**(26) I-1, T7S, R7E
 IDA**