

**SURVEY & REMONUMENTATION**

FEB 13 1998

RECEIVED FOR RECORD  
97 NOV 12 PM 1:52

**LAND CORNER RECORDATION CERTIFICATE**  
Filing Requirement of Act 74, Mich. P.A. 1970

*Peri Allen*  
REGISTER OF DEEDS  
MONROE COUNTY, MICH

**SECTION**

For corners in

MONROE (58)

(County)

Located in:

Corner Code #

1. Public Land Survey

T \_\_\_ R \_\_\_

T \_\_\_ R \_\_\_

IDA TWP.

T 7S R 7E K-6

T \_\_\_ R \_\_\_

2. Property Controlling in Section

S \_\_\_ T \_\_\_ R \_\_\_

S \_\_\_ T \_\_\_ R \_\_\_

3. Miscellaneous Property in Sec.


S \_\_\_ T \_\_\_ R \_\_\_

S \_\_\_ T \_\_\_ R \_\_\_

Register of Deeds Stamp & File Number

4. Lot No. \_\_\_\_\_, Recorded Plat \_\_\_\_\_  
5. Private Claims \_\_\_\_\_

I, G.B. Warnke, Jr., in a field survey on 1996-97, 19\_\_ do hereby state that under requirements of P.A. 74, Michigan P.A. of 1970, the corner points mentioned in lines 1 and 2 above were in conformance with regulations and rules therefore as required in the current manual of survey instructions of the United States Department of the Interior, Bureau of Land Management or by a decree of a Court of Law and/or that the corner points mentioned in lines 3, 4 and 5 above were in conformance with the rules of the Michigan Board of Land Surveyors or by a Decree of a Court of Law; established, re-established, monumented, recovered, found as expressed below:

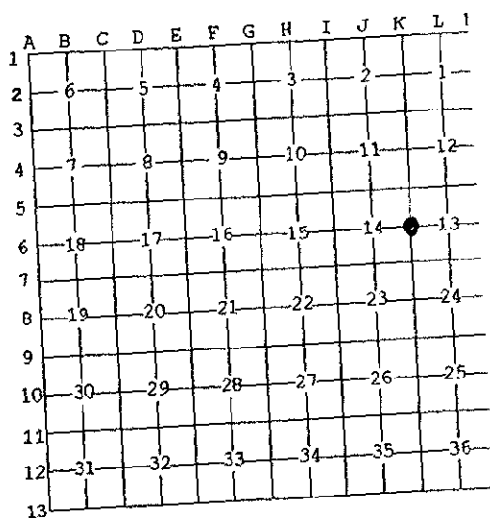

NOTE: Not more than 2 corners, all in the same town and range, may be recorded on this certificate.

**1997 G.B. Warnke Corner**

**1/4 Corner Common to Sections 13 & 14**

**On Geiger Road in gravel surface, between Lulu & Ida Center Roads**

- A. Description of original monument and accessories and/or subsequent restoration:
- 1820, G.L.O. Surveyor, Joseph Wampler, set 1/2 mile post, witnesses: W. Oak 26 in N86°E 4.16 lks
  - 1873, B.M. Wilcox survey notes show set stone
  - 1973 & 1977 A.J. Marino field notes show found nail and shiner with witnesses & found nail
  - 1982, Case & Fleck survey (#21065) shows found 1 inch iron
  - 1990, G.B. Warnke field notes, dated 6/1/90, show found square head bolt
  - 1990 & 1991, G.B. Warnke LCRC, Liber 3, Page 287 (& surveys #90-445 & #91-705), notes found split boulder, +/- 30 in remains of G.L.O. post below stone. Replaced with 3/4 inch x 42 inch pipe with square head bolt in top, place split boulder on either side of pipe & piled additional stones also around pipe.

B. Description of corner evidence found and/or method applied in restoring or reestablishing corner:

1996, G.B. Warnke survey (#91-0705 dated 7/2/96), found 3/4 inch pipe that replaced split stone per LCRC, Liber 3, Page 287 by G.B. Warnke & witnesses as shown below.

8/12/97, Ratified by Peer Group, PA 345 of 1990, Monroe County, Michigan, County Rep. *[Signature]*  
10/2/97, set 1" x 36" iron pipe, over found 3/4 inch pipe, with brass remonumentation cap.

C. Description of monument for corner and accessories established to perpetuate locating the position of the corner:

Set 1" x 36" iron pipe, over found 3/4 inch pipe, with brass remonumentation cap and is accepted as a careful and faithful perpetuation of the position of the original corner. Witnesses:

- North 17°59' West 19.42 feet to found bolt
- North 80° West 29.20 feet to northerly end of 72" CMP centerline
- South 66°18' West 24.60 feet to southerly end of 72" CMP centerline
- North 05°11' East 2688.34 feet to found 3/8 inch rod at K-5 (northwest corner Sec. 13, T.7S., R.7E.)
- South 05°06' West 2629.01 feet to found railroad spike at K-7 (southwest corner Sec. 13, T.7S., R.7E.)
- West +/- 8 feet centerline of 18-foot wide gravel roadway for Geiger Road

Signed by *[Signature]*  
Surveyor's Michigan License No. 19474

Date 10/7/1997



FORM APPROVED BY MICHIGAN STATE BOARD OF PROFESSIONAL SURVEYORS, JANUARY 1975  
REVISED MAY 1983  
REPEALED OCT. 1986