

SECTION

LAND CORNER RECORDATION CERTIFICATE
Filing Requirement of Act 74, Mich. P.A., 1970

For corners in
MONROE (58)
(County)

Located in: Corner Code #

- 1. Public Land Survey LASALLE TWP. F-7
- 2. Property Controlling in Section S T R _____
- 3. Miscellaneous Property in Sec. S T R _____
- 4. Lot No. _____, Recorded Plat _____
- 5. Private Claims _____

RECEIVED FOR RECORD
 99 DEC 28 AM 8:46
 REGISTER OF DEEDS
 MONROE COUNTY, MICH

1999 Remonumentation Program Corner

Register of Deeds Stamp & File Number

I, George B. Warnke, Jr., in a field survey on September, 1999 do hereby state that under requirements of P.A. 74, Michigan P.A. of 1970, the corner points mentioned in lines 1 and 2 above were in conformance with regulations and rules therefore as required in the current manual of survey instructions of the United States Department of the Interior, Bureau of Land Management or by decree of a Court of Law and / or that the corner points mentioned in lines 3, 4 and 5 above were in conformance with the rules of the Michigan Board of Land Surveyors or by a Decree of a Court of Law; established, re-established, monumented, recovered, found as expressed below:

NOTE: Not more than 2 corners, all in the same town and range, may be recorded on this certificate.

1	A	B	C	D	E	F	G	H	I	J	K	L	M
2		6		5		4		3		2		1	
3													
4		7		8		9		10		11		12	
5													
6		18		17		16		15		14		13	
7													
8		19		20		21		22		23		24	
9													
10		30		29		28		27		26		25	
11													
12		31		32		33		34		35		36	
13													

A. Description of original monument and accessories and/or subsequent restoration:

- 1820 - GLO - Joseph Wampler - notes did not mention the 1/4 corner.
- 1/1973 - Case & Fleck - Job #16988 - Liber 641, Page 171 - F.I. Rod -
N45°E 45.42 to face of P/ Pole & S50°E 51.20 to face of P/ Pole &
S45°E 147.00 to NW Cor. found
- 8/1974 - Case & Fleck - Job #18692 - Liber 684, Page 699 - FD IRON PIPE - witnesses match 1/1973 Case & Fleck
- 2/1976 - Case & Fleck - FD IRON ROD - witnesses match 1/1973 Case & Fleck
- 2/1976 - Case & Fleck - Job #19222 - Liber 710, Page 735 - witnesses match 1/1973 Case & Fleck
- 4/1988 - G.B. Warnke - Job #88-134 - Found Iron Rod -
S45°E 51.20' nail NW face pole & N45°E 45.15' nail SW face pole &
S45°W 58.13' top nut hyd't & N30°W 98.18 SE cor. house #2824
- 5/1989 - G.B. Warnke - Job #88-485 - found iron rod - witnesses match 4/1988 Warnke
- year ? - AJ Marino - notes - found iron rod - northerly 17.74' sign post & northeasterly 45.22' nail in P.P. &
southeasterly 51.12' nail in P.P. & southeasterly 72.74' nail in P.P. & southwesterly 58.16' CL fire hyd

B. Description of corner evidence found and/or method applied in restoring or re-establishing corner:


Corner is located at Yargerville road (E-W) & Dunlap Road (S) in asphalt pavement.
 9/3/1999 - found "+" cut railroad spike. Found 1/4" rod 0.3' deep 0.03 foot north & 0.12 foot west. Split difference. Dug hole 32" deep. Set 5/8" x 12" rebar & some clear glass and railroad spike & 1/2" x 24" rod at bottom of hole. The 1/4" rod appeared to be quite old but straight. Set 1" x 36" iron pipe with set brass remonumentation cap in set monument box. The original witnesses fit fairly well but were quite low so we set new nails & shiners.

RATIFIED BY PEER GROUP, PA 345 OF 1990, MONROE COUNTY, MICHIGAN, DATE 10/12/1999, COUNTY REP. [Signature]
 This position was not established by original government surveyors. This monument is accepted as the best available evidence of the position of the corner.

C. Description of monument for corner and accessories established to perpetuate locating the position of the corner:

- Set 1" x 36" pipe with set brass remonumentation cap in set monument box to replace found railroad spike & rod & Witnesses:
- South 25° East 72.76 feet to nail & remonumentation shiner in easterly face of telephone guy pole
- North 40° East 45.50 feet to set nail & remonumentation shiner in northwest utility pole
- South 70° East 118.00 feet to USGS BM #TT6L 1935
- South 20° West 76.89 feet to set nail & remonumentation shiner in easterly face of 12" Ash
- South 55° West 58.13 feet to top nut on hydrant

Signed by [Signature]
 Surveyor's Michigan License No. 19474

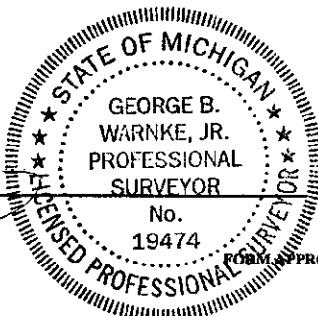

Date October 27, 1999

FORM APPROVED BY MICHIGAN STATE BOARD OF LAND SURVEYORS, JAN. 28, 1971
 REVISED MAY 14, 1975
 REVISED JAN., 1983
 REVISED OCT., 1994