

REMONUMENTATION

MAY 29 1987

COMMISSION

RECEIVED BY CLERK

96 DEC 13 PM 3:17

LAND CORNER RECORDATION CERTIFICATE
Filing Requirement of Act 74, Mich. P.A., 1970

Handwritten signature and text in the top right corner.

For corners in

Monroe (County)

Located In:

Corner Code #

Lasalle Twp.

1. Public Land Survey

T 7S R 8E

F-9

2. Property Controlling in Section

S T R

3. Miscellaneous Property in Sec.

S T R

S T R

Register of Deeds Stamp & File Number

4. Lot No., Recorded Plat

5. Private Claims

I, Bruce Antcliff, in a field survey on June, 1996 do hereby state that under requirements of P.A. 74, Michigan P.A. of 1970, the corner points mentioned in lines 1 and 2 above were in conformance with regulations and rules therefore as required in the current manual of survey instructions of the United States Department of the Interior, Bureau of Land Management or by decree of a Court of Law and / or that the corner points mentioned in lines 3, 4 and 5 above were in conformance with the rules of the Michigan Board of Land Surveyors or by a Decree of a Court of Law; established, re-established, monumented, recovered, found as expressed below.

NOTE: Not more than 2 corners, all in the same town and range, may be recorded on this certificate.

Monroe County Road Commission Corner

A. Description of original monument and accessories and/or subsequent restoration:

- Quarter corner common to Sections 21 & 28, T7S, R8E / Stein & Dunlap Road, Tarby over stone. 1820 GLO Surveyor Wampler set wood post; Ash, 10", N88W, 24 links; Elm, 14", S4W, 21 links. 1889, Baldwin, found stone; Maple, 10", N43W, 60 links; Willow, 30", S63W, 123 links. 1973, M.R. Fleck, found RR spike; S50E, 39.70', Nut on top of fire hydrant; N50W, 85.15', SE corner of 2 story frame house; N45E, 42.30', PK nail in power pole. 1975, Frank R. Moskos, Found RR spike (LCRC, L2, P70-71); NW, 39.70', street sign; SW, 56.63', Nail in telephone pole; NE, 42.40', PK nail in power pole. 1978, G.B. Wamke, found RR spike; S50E, 39.70', top nut on fire hydrant; N50W, 85.15', SE corner of residence; N45E, 42.5', PK nail in electric pole. 1989, J.C. Andrus, found RR spike 1993, John Blanchard, found RR spike; S45E, 39.61', top of fire hydrant; N40E, 42.56', PK nail in SW face of power pole; S60W, 55.06', PK nail in NE face of power pole.

B. Description of corner evidence found and/or method applied in restoring or re-establishing corner:

6/96, Found RR spike at surface, excavated 2'x2'x30" hole and probed an additional four feet. Found no evidence below RR spike.

C. Description of monument for corner and accessories established to perpetuate locating the position of the corner:

Set 1" x 36" iron pipe with brass remonumentation cap inside monument box to replace RR Spike and is accepted as the best evidence of the position of the original corner.


Witnesses:

NOTE: Set some new witnesses since some of the old witnesses were below road level.

- N52E, 42.64', Concrete nail/MCRC tag in SW face of power pole
S45W, 39.64', Top nut of fire hydrant
S70W, 55.58', Concrete nail/MCRC tag in NW face of utility pole
N44W, 85.06', SE corner of wood siding of house #2724
N05W, 134.47', Mag nail in East face of 24" Mulberry tree

RATIFIED BY PEER GROUP PA 345 OF 1990 MONROE COUNTY, MICHIGAN

date: 8/27/96 County Rep.:

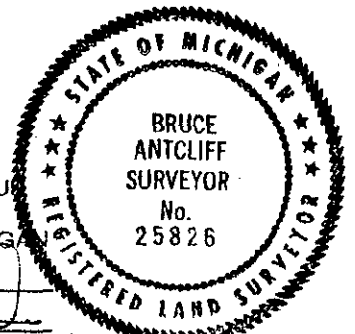

Signed by Bruce Antcliff

Date 11-13-96

Surveyor's Michigan License No. 25826