

RATIFIED BY PEER GROUP
 PA 345 OF 1990
 MONROE COUNTY, MICHIGAN
 date: 10/25/94
 County Rep.: [Signature]

LAND CORNER RECORDATION CERTIFICATE
 Filing Requirement of Act 74, Mich. P.A. 1970

RECEIVED FOR RECORD
 95 DEC 28 AM 9:00
 REGISTER OF DEEDS
 MONROE COUNTY MICHIGAN

For corners in

<u>Monroe</u> (County)	Located In:	Corner Code #
1. Public Land Survey Whiteford Twp.	T <u>8S</u> R <u>6E</u>	<u>A-13</u>
2. Property Controlling in Section	T <u> </u> R <u> </u>	<u> </u>
3. Miscellaneous Property in Sec.	S <u> </u> T <u> </u> R <u> </u>	<u> </u>
	S <u> </u> T <u> </u> R <u> </u>	<u> </u>

**SURVEY &
 REMONUMENTATION**

APR 04 1996

Register of Deeds Stamp & File Number

COMMISSION

4. Lot No. , Recorded Plat
 5. Private Claims

G.B. Warnke & Monroe Co. Road Commission Corner
 Bruce Antcliff 12/15 95
 I, G.B. Warnke, in a field survey on Sept, 1994 do hereby state that under requirements of P.A. 74, Michigan P.A. of 1970, the corner points mentioned in lines 1 and 2 above were in conformance with regulations and rules therefore as required in the current manual of survey instructions of the United States Department of the Interior, Bureau of Land Management or by a decree of a Court of Law and for that the corner points mentioned in lines 3, 4 and 5 above were in conformance with the rules of the Michigan Board of Land Surveyors or by a Decree of a Court of Law; established, re-established, monumented, recovered, found as expressed below:

1	A	B	C	D	E	F	G	H	I	J	K	L	M
2	6			5		4		3		2		1	
3													
4	7			8		9		10		11		12	
5													
6	18			17		16		15		14		13	
7													
8	19			20		21		22		23		24	
9													
10	30			29		28		27		26		25	
11													
12	31			32		33		34		35		36	
13													

NOTE: Not more than 2 corners, all in the same town and range, may be recorded on this certificate.

A. Description of original monument and accessories and/or subsequent restoration:


SW Corner Section 31, T8S, R6E, (common to A-1, T9S, R6E) Yankee Road and Lenawee County Line Road - Asphalt pavt.
 1820 GLO Surveyor Joseph Wampler set post at township corner witnessed: Ash 14 inch North 19°(?) East 16 links, Cottonwood 19 inch South 14° East 20 links. November 1885 Lenawee County Surveyor notes stone. Early 1900's J.L. Richard, Lenawee County Surveyor witnessed or set 3/8 inch x 2 inch x ? Strap iron, could not move as must be several feet long, road is 2 foot +/- above surrounding ground. May 1970 Glenn Richard, No. 13040, Lenawee County Surveyor, set 1/2 inch iron pipe at surface, found strap iron 1.3 feet deep. April 1981 survey by Glenn Richard, Job No. 810240, shows found 1/2 inch x 36 inch iron pipe.

B. Description of corner evidence found and/or method applied in restoring or reestablishing corner:

9/16/1994, Excavated corner to nearly 3 feet x 20 inches hole, at surface found 1/2 inch x 36 inch iron pipe at strap iron 1.5 feet deep. No stone or post found, reset 1/2 inch iron pipe below grade, left strap iron intact. Set 1 inch x 36 inch iron pipe in monument box over 1/2 inch iron pipe noted and witnessed as shown below.

C. Description of monument for corner and accessories established to perpetuate locating the position of the corner:

Set 1 inch x 36 inch iron pipe with brass remonumentation cap inside monument box over found pipe and is accepted as the best available evidence of the position of the original corner.
 Witnesses:
 North 35° East 29.10 feet to NE corner of concrete headwall.
 North 40° West 32.37 feet to nail/shiner in SE face of guy pole.
 South 50° West 41.52 feet to nail/shiner in NE face of utility pole.
 South 20° East 41.52 feet to nail/shiner in NW face of tel pole.
 North 74° East 29.80 feet to NE corner of concrete headwall.

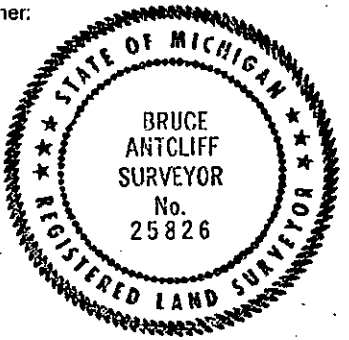

Signed by Bruce Antcliff
 Surveyor's Michigan License No. 25826

Date 12-22-95

⑪ A-13, T8S, R6E
 WHITEFORD TWP.