

RATIFIED BY PEER GROUP
PA 345 OF 1990
MONROE COUNTY, MICHIGAN

date: 10/25/94

County Rep.: [Signature]

LAND CORNER RECORDATION CERTIFICATE
Filing Requirement of Act 74, Mich. P.A. 1970

RECEIVED FOR RECORDS
95 DEC 29 AM 8:59
REGISTER OF DEEDS
MONROE COUNTY, MICH

For corners in

<u>Monroe</u> (County)	Located In:	Corner Code #
1. Public Land Survey Whiteford Twp.	T <u>8S</u> R <u>6E</u>	<u>B-13</u>
2. Property Controlling in Section	S <u> </u> T <u> </u> R <u> </u>	
3. Miscellaneous Property in Sec.	S <u> </u> T <u> </u> R <u> </u>	

SURVEY &
REMONUMENTATION
APR 04 1996

Register of Deeds Stamp & File Number

COMMISSION

4. Lot No. _____, Recorded Plat _____
5. Private Claims _____

G.B. Warnke & Monroe Co. Road Commission Corner
Bruce Antcliff 12/19 95
I, G.B. Warnke, in a field survey on Sept, 1994, do hereby state that under requirements of P.A. 74, Michigan P.A. of 1970, the corner points mentioned in lines 1 and 2 above were in conformance with regulations and rules therefore as required in the current manual of survey instructions of the United States Department of the Interior, Bureau of Land Management or by a decree of a Court of Law and for that the corner points mentioned in lines 3, 4 and 5 above were in conformance with the rules of the Michigan Board of Land Surveyors or by a Decree of a Court of Law; established, re-established, monumented, recovered, found as expressed below:

NOTE: Not more than 2 corners, all in the same town and range, may be recorded on this certificate.

A	B	C	D	E	F	G	H	I	J	K	L	M
1												
2	6		5		4		3		2		1	
3												
4	7		8		9		10		11		12	
5												
6	18		17		16		15		14		13	
7												
8	19		20		21		22		23		24	
9												
10	30		29		28		27		26		25	
11												
12	31		32		33		34		35		36	
13												

A. Description of original monument and accessories and/or subsequent restoration:


South 1/4 Corner Section 21, T8S, R6E, (not common to B-1, T9S, R6E)/ Yankee Road - Asphalt pavt.
1820 GLO Surveyor Joseph Wampler set post on south line Section 31 and witnessed: Sugar 5 inch South 88° East 12 links, Sugar 20 inch North 21° East 8 links. 1981 Glenn Richard, Michigan License No. 13040, set 3/4 inch gas pipe on south line of Section 31 as South 1/4 corner and witnessed in LCRC Liber 2, Page 419. Notes indicate passing a line through North 1/4 corner and center of Section 31.

B. Description of corner evidence found and/or method applied in restoring or reestablishing corner:

9/1994, Excavated corner found 3/4 inch x 24 inch iron pipe by Glenn Richard, replaced with 1 inch x 36 inch iron pipe and witnessed as shown below.

C. Description of monument for corner and accessories established to perpetuate locating the position of the corner:

Set 1 inch x 36 inch iron pipe with brass remonumentation cap inside monument box to replace found iron pipe and is accepted as the best available evidence of the position of the original corner.
Witnesses:
North 40° East 27.97 feet to pk nail/shiner in SW face of 24 inch tree.
North 6° East 153.79 feet to SE corner of house no. 8634.
North 20° West 23.90 feet to nail/shiner in East root of 26 inch tree.
North 15° West 156.47 feet to SW corner of house no. 8634.
North 70° West 68.00 feet to boat spike in South face of 21 inch walnut.

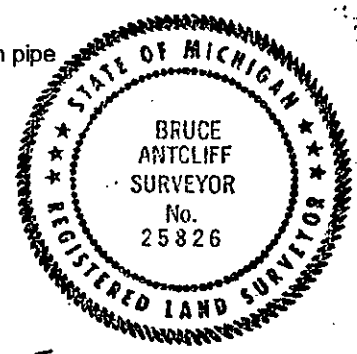

Signed by Bruce Antcliff
Surveyor's Michigan License No. 25826

Date 12-22-95

ⓑ B-13, T8S, R6E
WHITEFORD TWP.