

SURVEY & REMONUMENTATION

FEB 13 1998

SECTION

**LAND CORNER RECORDATION CERTIFICATE
Filing Requirement of Act 74, Mich. P.A., 1970**

For corners in

MONROE (58)
(County)

Located In:

Corner Code #

WHITEFORD TWP.

- 1. Public Land Survey
- 2. Property Controlling in Section
- 3. Miscellaneous Property in Sec.

T8S	R6E	C-4
T	R	
T	R	
T	R	
S	T	R
S	T	R
S	T	R
S	T	R

RECEIVED FOR RECORD
 97 DEC 30 PM 3:46
Frank Allen
 REGISTER OF DEEDS
 MONROE COUNTY, MICH


Register of Deeds Stamp & File Number

4. Lot No. _____, Recorded Plat _____

5. Private Claims _____

1997 REMONUMENTATION PROGRAM CORNER

I, George B. Warnke, Jr., in a field survey on September - October, 1997 do hereby state that under requirements of P.A. 74, Michigan P.A. of 1970, the corner points mentioned in lines 1 and 2 above were in conformance with regulations and rules therefore as required in the current manual of survey instructions of the United States Department of the Interior, Bureau of Land Management or by decree of a Court of Law and / or that the corner points mentioned in lines 3, 4 and 5 above were in conformance with the rules of the Michigan Board of Land Surveyors or by a Decree of a Court of Law; established, re-established, monumented, recovered, found as expressed below:

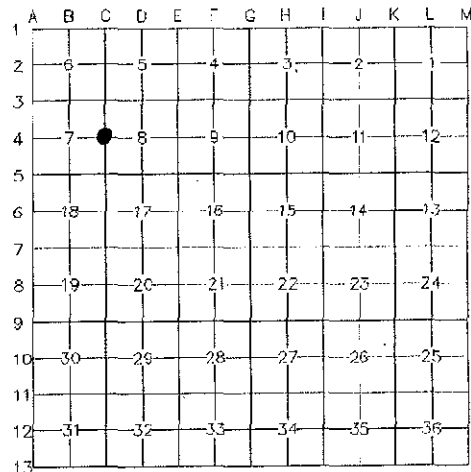

NOTE: Not more than 2 corners, all in the same town and range, may be recorded on this certificate.

A. Description of original monument and accessories and/or subsequent restoration:

- 1820 GLO, Joseph Wampler - Dep. Surveyor, set the 1/2 mile post from which a Hickory 16 ins. dia. bears S23E 12 lks. dis. & and Ironwood 9 ins. dia. bears N20W 18 lks. dis.
- 1930 J.W. White survey notes Stone
- 1965 Michigan State Highway Department Witness Card notes found small stone approx. 3" diameter inside 4" tile; replaced with 3/4" iron rod - witnesses: S40°E 40.78' power pole / S58°W 47.74' guy pole / N54°W 42.30' telephone pole
- 1979 Michigan State Highway Department Witness Card & LCRC, Liber 2, Page 311-312, notes 1/2" rod with mushroom head in mon. box - mon. box is 0.6' S. of N. E.M. US223 - witnesses: N20°W 46.99' PK nail in curb / N25°E 64.62' P. pole / N45°E 44.29' PK nail in curb
- 1979 Angelo J. Marino survey notes Fd. I.R. in Mon. Box
- 1980 Angelo J. Marino field notes show Mon. box
- 1992 Glenn Richard, LCRC, Liber 3, Page 239, notes found iron rod in monument box in new concrete pavement - witnesses: Dbl hd nail & disc in: Elec pole N25°E 64.47 & Elec pole S20°E 93.35
"X" cut on top conc culv: S45°W 72.63 & N50°W 63.61
- 1997 David Arthur Consultants Survey #97-D-649, recorded in Liber 1589, Page 0349, notes Fnd. Mon. Box

B. Description of corner evidence found and/or method applied in restoring or re-establishing corner:

9/26/1997, George B. Warnke, Jr. crew found iron rod with 0.12' dia. (state with no printing) brass cap in existing monument box near north edge of concrete pavement at intersection of Stone Quarry Road & checked previous witnesses.

RATIFIED BY PEER GROUP, PA 345 OF 1990, MONROE COUNTY, MICHIGAN, DATE 10/14/1997, COUNTY REP. *[Signature]*

10/21/1997, G.B. Warnke crew removed existing rod with brass cap and attempted to set 1" x 36" iron but could not drive it further than 20 inches. Set a 3/4" x 20" pipe and drove old rod inside pipe and set brass remonumentation cap on rod

C. Description of monument for corner and accessories established to perpetuate locating the position of the corner:

- Set 3/4" x 20" pipe with found iron rod inside with brass remonumentation cap on rod in existing monument box on north edge of concrete Pavement and to accept as the best available evidence of the position of the original corner. Witnesses:
- North 20° West 46.99' set concrete nail & washer in curb joint at top of curb
- North 25° East 64.43 feet to DH nail in easterly face of electric pole
- North 45° East 44.29 feet to PK nail in conc. curb
- North 50° West 63.61 feet to "+" cut in top of north end of culvert

Signed by *[Signature]*
Surveyor's Michigan License No. 19474

Date December 3, 1997



FORM 1000-1 REVISED BY MICHIGAN STATE BOARD OF LAND SURVEYORS, JAN. 28, 1
REVISED MAY 14, 1
REVISED JAN., 1
REVISED OCT., 1