

RATIFIED BY PEER GROUP  
PA 345 OF 1990  
MONROE COUNTY, MICHIGAN

Date: 10/25/94

*[Signature]*

LAND CORNER RECORDATION CERTIFICATE  
Filing Requirement of Act 74, Mich. P.A. 1970

For corners in  
Monroe (58)

(County)

Located In:

Corner Code #

- 1. Public Land Survey  
WHITEFORD TWP. T 8S R 6E C-13
- 2. Property Controlling  
in Section S      T      R
- 3. Miscellaneous  
Property in Sec. S      T      R

SURVEY &  
REMONUMENTATION

APR 04 1996

Register of Deeds Stamp & File Number

- 4. Lot No. \_\_\_\_\_, Recorded Plat \_\_\_\_\_
- 5. Private Claims \_\_\_\_\_

COMMISSION

George B. Warnke, Jr. & Monroe County Road Commission Corner

I, G.B. WARNKE, JR. in a field survey on 1994 & 1995, 19 \_\_\_\_\_, do hereby certify that under requirements of P.A. 74, Michigan P.A. of 1970, the corner points mentioned in lines 1 and 2 above were in conformance with regulations and rules therefore as required in the current manual of survey instructions of the United States Department of the Interior, Bureau of Land Management or by a decree of a Court of Law and/or that the corner points mentioned in lines 3, 4 and 5 above were in conformance with the rules of the Michigan Board of Land Surveyors or by a Decree of a Court of Law; established, re-established, monumented, re-monumented, recovered, found as expressed below:

**NOTE: Not more than 4 corners, all in the same town and range, may be recorded on this certificate.**

A. Description of original monument and accessories and/or subsequent restoration:

Section Corner Common to Sections 32 & 33, T8S, R6E, on south line of township  
On Yankee Road - asphalt over stone over sand / not common to C-1, T9S, R6E  
1820, G.L.O. Surveyor, Joseph Wampler, set post at Section corner and witnessed: Maple 14 S36°W 5 links & Sycamore 13 N88°E 20 links. 1968, John Weithman set or used P.K. nail as corner. 1977 and 1981, Glenn Richard used a found P.K. nail in his surveys, recorded L.C.R.C. 1981, Liber 2, Page 419.

B. Description of corner evidence found and/or method applied in restoring or reestablishing corner:


9/1994, P.K. nail was not found. Right-of-way monument is gone, fences have been moved back. Temporary nails are set based on known section corners and noted surveys. 10/25/1994 - corner was Peer Group approved. 12/1995 - set 1" x 36" iron pipe with brass remonumentation cap in monument box.

C. Description of monument for corner and accessories established to perpetuate locating the position of the corner:

Set 1" x 36" iron pipe with brass remonumentation cap in monument box and is accepted as a careful and faithful reestablishment of the position of the original corner and Witnesses:  
Westerly 630.28 feet to R.R. spike by Clark Road  
South 17.44 feet to 5/8" I. rebar set for witness point  
Easterly 2380.57 feet to D-13, T8S, R6E, as monumented by brass remon. cap on 1" iron pipe in mon. box  
North 45° West 45.99 feet to southeast corner of brick fence pillar  
North 55° East 84.65 feet to southwest corner of brick fence pillar

Signed by *[Signature]*  
Surveyor's Michigan License No. 19474

Date 12/19/1995

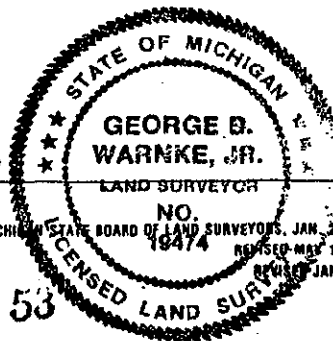

RECORDED FOR RECORDS  
 95 DEC 29 AM 9:59  
 REGISTER OF DEEDS  
 MONROE COUNTY, MICHIGAN

	A	B	C	D	E	F	G	H	I	J	K	L	A
2	6		5		4		3		2		1		
3													
4	7		8		9		10		11		12		
5													
6	18		17		16		15		14		13		
7													
8	19		20		21		22		23		24		
9													
10	30		29		28		27		26		25		
11													
12	31		32		33		34		35		36		
13													

(17) C-13 T8S R6E WHITEFORD