

Date: 10/25/94

County Rep.:

**LAND CORNER RECORDATION CERTIFICATE**  
Filing Requirement of Act 74, Mich. P.A. 1970

For corners in  
Monroe (58)

(County)

Located In:

Corner Code ##

1. Public Land Survey  
WHITEFORD TWP.

T 8S R 6E

D-13

2. Property Controlling  
in Section

S      T      R     

**SURVEY &  
REMONUMENTATION**

3. Miscellaneous  
Property in Sec.

S      T      R     

APR 04 1996

Register of Deeds Stamp & File Number

4. Lot No. \_\_\_\_\_, Recorded Plat \_\_\_\_\_

**COMMISSION**

5. Private Claims \_\_\_\_\_

George B. Warnke, Jr. & Monroe County Road Commission Corner

I, G.B. WARNKE, JR., in a field survey on 1994 & 1995, 19\_\_\_\_ do hereby certify that under requirements of P.A. 74, Michigan P.A. of 1970, the corner points mentioned in lines 1 and 2 above were in conformance with regulations and rules therefore as required in the current manual of survey instructions of the United States Department of the Interior, Bureau of Land Management or by a decree of a Court of Law and/or that the corner points mentioned in lines 3, 4 and 5 above were in conformance with the rules of the Michigan Board of Land Surveyors or by a Decree of a Court of Law; established, re-established, monumented, re-monumented, recovered, found as expressed below:

**NOTE: Not more than 4 corners, all in the same town and range, may be recorded on this certificate.**

	A	B	C	D	E	F	G	H	I	J	K	L
2	6		5	4	3	2	1					
3												
4	7	8	9	10	11	12						
5												
6	18	17	16	15	14	13						
7												
8	19	20	21	22	23	24						
9												
10	30	29	28	27	26	25						
11												
12	31	32	33	34	35	36						
13												

A. Description of original monument and accessories and/or subsequent restoration:

South 1/4 Corner Sections 32 on south line of township ( not common to D-1, T9S, R6E )  
On Yankee Road (tarby surface)  
1820 G.L.O. Surveyor Joseph Wampler set 1/4 post and witnessed: Sugar 30 inch North 16° West 19 links, Sugar 5 inch South 17° West 6 links. 1968 Dana survey by John Weithman corner not noted. 1977 Glenn Richard set P.K. nail per Dana survey (Weithman) recorded 1977 L.C.R.C. Liber 2, Page 237.

B. Description of corner evidence found and/or method applied in restoring or reestablishing corner:


D-13 - 9/1994, No evidence found, set temporary nail based on calculating information from Weithman & Richard & evidence in field (copies are in the corner dossier). 10/25/94 - corner was Peer Group approved. 12/13/1995 - Monroe County Road Commission crew set brass remonumentation cap on 1" x 36" iron pipe inside monument box and witnessed as shown below.

C. Description of monument for corner and accessories established to perpetuate locating the position of the corner:

Set brass remonumentation cap on 1" x 36" iron pipe inside monument box and is accepted as a careful and faithful reestablishment of the position of the original corner and witnesses:  
North 33° East 47.65 feet to "+" in south face of fence post / 2' above ground  
North 58° West 71.35 feet to "+" in south face of fence post / 2' above ground  
South 25° East 94.34 feet to duplex nail & shiner in north face of power pole  
South 18.17 feet to 5/8" iron rebar in top of bank of ditch  
North 80° West 314.61 feet to D-1, T9S, R6E, as monumented by brass remon. cap in 1" iron pipe inside monument box

Signed by [Signature]  
Surveyor's Michigan License No. 19474

Date 12/20/1995

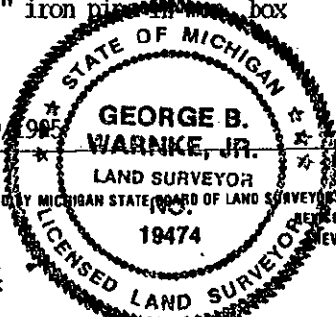

FORM APPROVED BY MICHIGAN STATE BOARD OF LAND SURVEYORS, JAN. 28, 1971  
REVISED MAY 14, 1971  
REVISED JAN., 1994