

RATIFIED BY PEER GROUP  
PA 345 OF 1990  
MONROE COUNTY, MICHIGAN

date: 8-10-1995

**LAND CORNER RECORDATION CERTIFICATE**  
Filing Requirement of Act 74, Mich. P.A. 1970

County Rep.: [Signature]

For corners in  
Monroe (58)

Located In: \_\_\_\_\_ Corner Code: # \_\_\_\_\_

- |   |  |   |
|---|--|---|
| 1. Public Land Survey<br>Whiteford Twp. | T _____ R _____<br>T <u>8S</u> R <u>6E</u><br>T _____ R _____<br>T _____ R _____ | _____ E-4 _____<br>_____<br>_____       |
| 2. Property Controlling<br>in Section   | S _____ T _____ R _____<br>S _____ T _____ R _____                               | _____ SURVEY &<br>REMONUMENTATION _____ |
| 3. Miscellaneous<br>Property in Sec.    | S _____ T _____ R _____<br>S _____ T _____ R _____                               | _____                                   |

RECEIVED FOR RECORD  
 95 DEC 28 AM 9:05  
 REGISTER OF DEEDS  
 MONROE COUNTY, MICH.

Register of Deeds Stamp & File Number

APR 04 1996

4. Lot No. \_\_\_\_\_, Recorded Plat \_\_\_\_\_  
5. Private Claims \_\_\_\_\_

COMMISSION

1995 REMONUMENTATION PROGRAM

I, G.B. WARNKE, JR., in a field survey on Aug.-Dec., 1995, 19\_\_\_\_ do hereby certify that under requirements of P.A. 74, Michigan P.A. of 1970, the corner points mentioned in lines 1 and 2 above were in conformance with regulations and rules therefore as required in the current manual of survey instructions of the United States Department of the Interior, Bureau of Land Management or by a decree of a Court of Law and/or that the corner points mentioned in lines 3, 4 and 5 above were in conformance with the rules of the Michigan Board of Land Surveyors or by a Decree of a Court of Law; established, re-established, monumented, re-monumented, recovered, found as expressed below:

A	B	C	D	E	F	G	H	I	J	K	L	M
2	6	5	4	3	2	1						
3												
4	7	8	9	10	11	12						
5												
6	18	17	16	15	14	13						
7												
8	19	20	21	22	23	24						
9												
10	30	29	28	27	26	25						
11												
12	31	32	33	34	35	36						
13												

**NOTE: Not more than 4 corners, all in the same town and range, may be recorded on this certificate.**

A. Description of original monument and accessories and/or subsequent restoration:


1/4 Corner common to Sections 8 & 9 / at Lake Road & M-151 - hard surface.  
1820, GLO Surveyor, J. Wampler, set wood post - witnesses: W. Oak 14 S34W 34 & Maple 14 N40E 3.  
1900's, old survey books, East 1/4 corner of Sec. 8 notes stone. 1970, A.J. Marino survey notes F. R.R. spike.  
1974, Douglas Hooth, MSHD, found 1 1/4" Iron Pipe. G.B. Warnke - 1977 I. pin & 1986 found 1 1/4" iron pipe in monument box, raised to surface with 1/2" rebar & 1986 iron pin in monument box as recorded in survey, Liber 979, Page 167. 1992, G. Richard recorded LCRC, Liber 3, Page 239, found 1 1/4" pipe 30"+/- deep in mon. box

B. Description of corner evidence found and/or method applied in restoring or reestablishing corner:

8/95 - Found 1/2 inch rebar in monument box. 8/10/95 - corner approved by Peer Group.  
9/28/95 - G.B. Warnke crew set brass remonumentation cap on found 1/2 inch rebar in monument box.

C. Description of monument for corner and accessories established to perpetuate locating the position of the corner:

Set brass remonumentation cap on found 1/2 inch rebar in monument box and is accepted as the best available evidence of the position of the original corner and witnesses:  
South 34° East 63.10 feet to a found nail/tag in southeast face of electric pole  
South 85° West 75.90 feet to found cut "X" in west end of concrete curb  
North 60° West 69.08 feet to found cut "X" in west end of concrete curb  
North 16.10 feet to centerline of concrete pavement of US 223

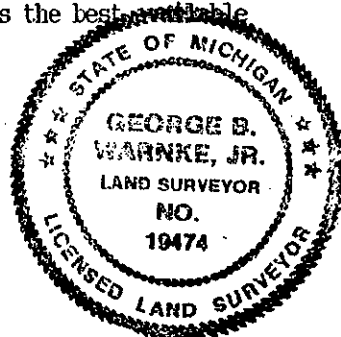

Signed by [Signature] Date 12/19/1995  
Surveyor's Michigan License No. 19474

(12) E-4 (8/6) WHITEFORD TWP