

RATIFIED BY PEER GROUP
PA 345 OF 1990
MONROE COUNTY, MICHIGAN

date: Oct 25, 1994
County Rep.: [Signature]

LAND CORNER RECORDATION CERTIFICATE
Filing Requirement of Act 74, Mich. P.A. 1970

For corners in

Monroe Located In: Corner Code #
(County)

1. Public Land Survey T R
Whiteford Twp. T 8S R 6E E-13
T R
T R
2. Property Controlling S T R
in Section S T R
3. Miscellaneous S T R
Property in Sec. S T R

REGISTERED FOR RECORD
55 DEC 29 AM 8:57

SURVEY &
REMONUMENTATION

APR 04 1996

Register of Deeds Stamp & File Number

4. Lot No. _____, Recorded Plat _____ COMMISSION
5. Private Claims _____

G.B. Warnke & Monroe Co. Road Commission Corner
Bruce Antcliff 12/15 95

I, G.B. Warnke, in a field survey on Sept, 1994, do hereby state that under requirements of P.A. 74, Michigan P.A. of 1970, the corner points mentioned in lines 1 and 2 above were in conformance with regulations and rules therefore as required in the current manual of survey instructions of the United States Department of the Interior, Bureau of Land Management or by a decree of a Court of Law and/or that the corner points mentioned in lines 3, 4 and 5 above were in conformance with the rules of the Michigan Board of Land Surveyors or by a Decree of a Court of Law, established, re-established, monumented, recovered, found as expressed below:

1	A	B	C	D	E	F	G	H	I	J	K	L
2	6		5		4		3		2		1	
3												
4	7		8		9		10		11		12	
5												
6	18		17		16		15		14		13	
7												
8	19		20		21		22		23		24	
9												
10	30		29		28		27		26		25	
11												
12	31		32		33		34		35		36	
13												

NOTE: Not more than 2 corners, all in the same town and range, may be recorded on this certificate.

A. Description of original monument and accessories and/or subsequent restoration:

Section Corner common to Sections 32 & 33, T8S, R6E, (common to E-1, T9S, R6E)/ Yankee Road and Lenawee County Line Road - Asphalt pavt.
1820 GLO Surveyor Joseph Wampler set post at township line, no witness trees noted.
October 1908, J.W. White notes stone at SE corner Section 32, T8S, R6E, Book 8, Page 23.
1953 A.J. Marino notes RR spike; 1955 A.J. Marino notes a F.I.(?) As corner; 1956 A.J. Marino notes found I Bolt; 12/1968 John Weithman #13429 notes SE corner Section 32, T8S, R6E, as found bolt with conc monument 33 feet north. 1971 Glenn Richard set RR spike from RW monument. 1992 George Warnke found RR spike.

B. Description of corner evidence found and/or method applied in restoring or reestablishing corner:


9/19/1994, Excavated corner to 22 inches x 20 inches hole; found 6" x 12" cut stone, could not move. Drilled hole in center of stone and set 1/2 inch by 22 inch rebar. Stone is 0.35 feet north and 1.25 feet west of recorded RR spike. Set 1 inch x 36 inch iron pipe in monument box to replace RR spike and witnessed as shown below.

C. Description of monument for corner and accessories established to perpetuate locating the position of the corner:

Set 1 inch x 36 inch iron pipe with brass remonumentation cap inside monument box to replace RR spike and is accepted as the best available evidence of the position of the original corner.

Witnesses:

- North 27° East 96.66 feet to SW corner of brick house.
- North 3° West 30.73 feet to nail/shiner in South face of tel pole.
- South 12° West 53.14 feet to nail/shiner in North face of power pole.
- South 32.98 feet to 1/2 inch i.p. ingrown in East face of 18 inch tree.
- North 5° East 33.03 feet to 6 inch concrete monument.

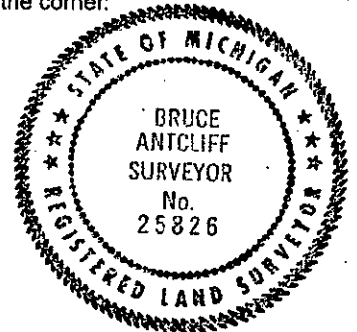

Signed by Bruce Antcliff
Surveyor's Michigan License No. 25826

Date 12-22-95

(21) E-13, T8S, R6E
WHITEFORD TWP.