

RATIFIED BY PEER GROUP  
PA 345 OF 1990  
MONROE COUNTY, MICHIGAN

date: 8/10/95

**LAND CORNER RECORDATION CERTIFICATE**

Filing Requirement of Act 74, Mich. P.A. 1970

County Rep.: \_\_\_\_\_

For corners in

Monroe (58)

(County)

Located In:

Corner Code #

- |                         |   |           |   |           |            |
|-------------------------|---|-----------|---|-----------|------------|
| 1. Public Land Survey   | T | _____     | R | _____     | _____      |
| Whiteford Twp.          | T | <u>8S</u> | R | <u>6E</u> | <u>G-3</u> |
|                         | T | _____     | R | _____     | _____      |
|                         | T | _____     | R | _____     | _____      |
| 2. Property Controlling | S | _____     | T | _____     | _____      |
| in Section              | S | _____     | T | _____     | _____      |
| 3. Miscellaneous        | S | _____     | T | _____     | _____      |
| Property in Sec.        | S | _____     | T | _____     | _____      |

**SURVEY &  
REMONUMENTATION**

Register of Deeds Stamp & File Number

APR 04 1996

4. Lot No. \_\_\_\_\_, Recorded Plat \_\_\_\_\_

5. Private Claims \_\_\_\_\_

**COMMISSION**

**1995 REMONUMENTATION PROGRAM**

I, G.B. WARNKE, JR., in a field survey on 1995, 19\_\_\_\_\_, do hereby certify that under requirements of P.A. 74, Michigan P.A. of 1970, the corner points mentioned in lines 1 and 2 above were in conformance with regulations and rules therefore as required in the current manual of survey instructions of the United States Department of the Interior, Bureau of Land Management or by a decree of a Court of Law and/or that the corner points mentioned in lines 3, 4 and 5 above were in conformance with the rules of the Michigan Board of Land Surveyors or by a Decree of a Court of Law; established, re-established, monumented, re-monumented, recovered, found as expressed below:

**NOTE: Not more than 4 corners, all in the same town and range, may be recorded on this certificate.**

	A	B	C	D	E	F	G	H	I	J	K	L
2	6		5		4		3		2		1	
3							●					
4	7		8		9		10		11		12	
5												
6	16		17		18		15		14		13	
7												
8	19		20		21		22		23		24	
9												
10	30		29		28		27		26		25	
11												
12	31		32		33		34		35		36	
13												

**A. Description of original monument and accessories and/or subsequent restoration:**

Section Corner common to Sections 3, 4, 9 & 10 / At Sylvania Petersburg Road and Samaria Road : - 9" thick asphalt pavement over clay.  
1820, GLO Surveyor, J. Wampler, set wood post - witnesses: W. Oak 23 S56E 17 & Elm 12 N26W 20.  
1893, A.F. Winney found post - witnesses: Elm 30" N58E 3.06 & SE corner school House N 68°50' W 2.02 chains.  
1963, A.J. Marino field notes state P. NAIL & used several other times without noting material. 1972 to present, G.B. Warnke - 1972 survey recorded in Liber 631, Page 536, notes Fd. stone & set bolt @ surface & 1992 LCRC recorded in Liber 3, Page 232, notes 5/8" bolt over stone. 1974, Douglas Hooth, MSHD, recorded LCRC, Liber 1, Page 488, to found 5/8" bolt or R.R. spike. 1975, M.R. Fleck survey states Fd. bolt over stone.


**B. Description of corner evidence found and/or method applied in restoring or reestablishing corner:**

1995 - Found 5/8 inch bolt over stone and checked to past witnesses. 8/10/95 - Corner was Peer Group approved. 11/7/95 - Warnke crew replaced bolt & stone with 1 inch x 36" iron pipe inside monument box and witnessed as shown below. 12/5/95 - Warnke crew set brass remonumentation cap on iron pipe.

**C. Description of monument for corner and accessories established to perpetuate locating the position of the corner:**

1" x 36" iron pipe with brass remonumentation cap inside monument box and is accepted as the best available evidence of the position of the original corner and witnesses:  
(11/95 - old school house witness now gone)  
North 45° West 115.0 feet to southeast corner brick res'd # 6710  
North 30° West 42.68 feet to southeast corner of concrete wall (3 sided surrounding a well casing)  
South 30° West 39.85 feet to found double headed nail & shiner in southeast face of electric pole  
South 30° East 46.64 feet to found nail & shiner in west face of telephone pole  
South 20° East 84.64 feet to found nail & shiner in westerly root of 22" Hickory tree

Signed by *George D. Warnke, Jr.* Date 12/19/1995  
Surveyor's Michigan License No. 19474

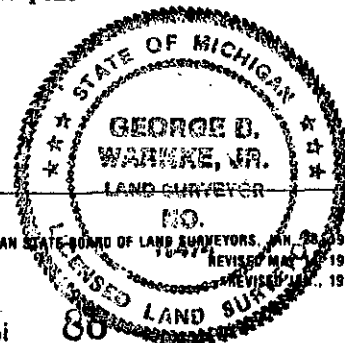

FORM APPROVED BY MICHIGAN STATE BOARD OF LAND SURVEYORS, JAN 28, 1991, REVISED MAR 1991

(13) R-3, T8S, R6E, WHITEFORD TWP