

SURVEY & REMONUMENTATION

FEB 13 1998

SECTION

**LAND CORNER RECORDATION CERTIFICATE
Filing Requirement of Act 74, Mich. P.A., 1970**

For corners in

<u>Monroe</u> (County)	Located In:	Corner Code #
	Whiteford	
1. Public Land Survey	T <u>8</u> R <u>6</u>	<u>G-6</u>
	T _____ R _____	_____
	T _____ R _____	_____
	T _____ R _____	_____
2. Property Controlling in Section	S _____ T _____ R _____	_____
	S _____ T _____ R _____	_____
3. Miscellaneous Property in Sec.	S _____ T _____ R _____	_____
	S _____ T _____ R _____	_____

RECEIVED FOR RECORD
 97 DEC 30 PM 3:13
 Register of Deeds
 Monroe County, Mich.
Scott A. Warnke

Register of Deeds Stamp & File Number

4. Lot No. _____, Recorded Plat _____

5. Private Claims _____

I, Scott A. Warnke / M.C.R.C., in a field survey on June 25, 1997 do hereby state that under requirements of P.A. 74, Michigan P.A. of 1970, the corner points mentioned in lines 1 and 2 above were in conformance with regulations and rules therefore as required in the current manual of survey instructions of the United States Department of the Interior, Bureau of Land Management or by decree of a Court of Law and / or that the corner points mentioned in lines 3, 4 and 5 above were in conformance with the rules of the Michigan Board of Land Surveyors or by a Decree of a Court of Law; established, re-established, monumented, recovered, found as expressed below:

NOTE: Not more than 2 corners, all in the same town and range, may be recorded on this certificate.

Monroe County Road Commission Corner

A. Description of original monument and accessories and/or subsequent restoration:

- 1820 Wampler set wood post; White Oak, 30", South 29 links; Maple, 19", N63°W 37 links.
- January 1991 G.B. Warnke L.P.S. #19474 found Iron pipe for survey job no. 91-120.
- June 1991 G.B. Warnke recorded Iron pipe in L.C.R.C. Liber 3, Page 165.
- S75°W, 28.82' to shiner in NE side of pole.
- N45°E, 35.03' to M.D.S.H. tag in south side of pole.
- N60°E, 71.92' to M.D.S.H. tag in south side of pole.
- S80°E, 47.27' to S. edge of Stop sign post.


B. Description of corner evidence found and/or method applied in restoring or re-establishing corner:

June 25, 1997, Excavated a 2'x2'x2.5' deep hole and found a bent 1/2" Iron pipe 6" below road. Found a 5/8" Iron pipe, 12" below road, 0.05' West of 1/2" Iron pipe. Did not find any other evidence. Set a 1" x 36" Iron pipe with a brass Remonumentation disk inside monument box.

RATIFIED BY PEER GROUP, P.A. 345 OF 1990, MONROE CO., MICHIGAN; COUNTY REP.: *[Signature]*, **DATE:** 7/1

C. Description of monument for corner and accessories established to perpetuate locating the position of the corner:

- 1" x 36" Iron pipe with brass Remonumentation disk inside monument box.
- Witnesses: S70°W, 28.82' to nail / tag in NE side of Telephone pole.
- N45°E, 35.03' to nail / M.D.O.T. tag in South face of Telephone pole.
- N55°E, 71.95' to nail / M.D.O.T. tag in South face of Telephone pole.
- S20°E, 115.24' to nail / tag in South side of power pole.

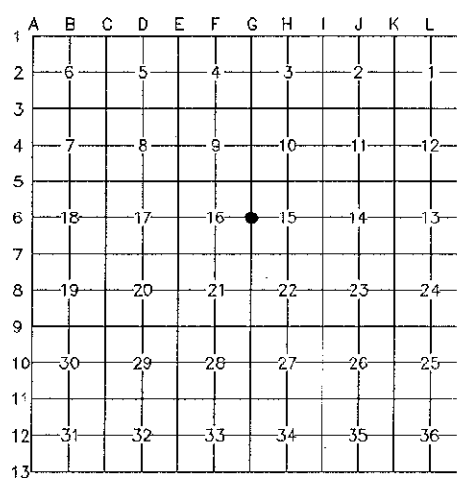

Signed by Scott A. Warnke

Date 12-10-97

Surveyor's Michigan License No. 41913