

SURVEY & REMONUMENTATION

MAY 20 1997

COMMISSION

RECEIVED FOR RECORD

96 DEC 13 PM 3:18

LAND CORNER RECORDATION CERTIFICATE
Filing Requirement of Act 74, Mich. P.A., 1970

Handwritten signature and text: Bruce Antcliff, Registered Land Surveyor, No. 25826

For corners in

Form with fields: Monroe (County), Located In: Whiteford Twp., Corner Code #: G-8. Includes sections for Public Land Survey, Property Controlling in Section, and Miscellaneous Property in Sec.

Register of Deeds Stamp & File Number

4. Lot No. Recorded Plat

5. Private Claims

I, Bruce Antcliff, in a field survey on August 19 96 do hereby state that under requirements of P.A. 74, Michigan P.A. of 1970, the corner points mentioned in lines 1 and 2 above were in conformance with regulations and rules therefore as required in the current manual of survey instructions of the United States Department of the Interior, Bureau of Land Management or by decree of a Court of Law and / or that the corner points mentioned in lines 3, 4 and 5 above were in conformance with the rules of the Michigan Board of Land Surveyors or by a Decree of a Court of Law; established, re-established, monumented, recovered, found as expressed below.

NOTE: Not more than 2 corners, all in the same town and range, may be recorded on this certificate.

Monroe County Road Commission Corner

A. Description of original monument and accessories and/or subsequent restoration:

Quarter corner common to sections 21 & 22, T8S, R6E, Whiteford township / Sylvania-Petersburg & Consear Road, Asphalt over stone 1820, GLO Surveyor Wampler set wood post; Hickory 8", N40W, 7 links; Ash 7", S60E, 12 links 1925, MCRC, Road survey; no mention of corner 1976, Marino survey; tied to corner, no description or witnesses Dec., 1978, G.B.Warnke, Field notes, found RR spike 0.2' deep; N45W, 37.36', BM nail N face of utility pole; N45W, 27.74', SE corner conc. headwall; S45W, 39.22', Nail NW face of tel. pole; S45E, 45.73', Nail SW face of tel. pole Dec., 1978, G.B.Warnke, Survey & LCRC L2, P347; found iron 0.2' deep; same wits. as above April, 1985, G.B.Warnke, Survey & LCRC L3, P7; found RR spike

B. Description of corner evidence found and/or method applied in restoring or re-establishing corner:

Found RR spike at surface. Excavated 3'x3' hole and found the following: 1.5" dia. wood stake 0.2'S & 0.2'E of RR spike, 2' deep; 3/4" dia. wood stake, carved point, 1.21'S & 1.19'W of RR spike; Granite stone 1.50'S & 1.0'W of RR spike; 1.5" square stake, 2.8' deep, 1.62'S & 1.45'W of RR spike. Stone appears to be laying on side and if placed upright would be in same position as 3/4" stake.


C. Description of monument for corner and accessories established to perpetuate locating the position of the corner:

Set 1"x36" iron-pipe with brass remonumentation cap inside monument box to replace R.R.Spike and is accepted as the best available evidence of the position of the original corner.

Witnesses:

- N45W, 36.86', Nail/tag NE side of power pole
S45E, 45.61', Nail/tag SW side of telephone pole
S80W, 151.75', Nail/MCRC tag N side of telephone pole
S45W, 39.41', Nail/MCRC tag N side of telephone pole
N45W, 28.68', NW corner of north wingwall

RATIFIED BY PEER GROUP
PA 345 OF 1990
MONROE COUNTY, MICHIGAN
date: 9/24/1996
County Rep.:

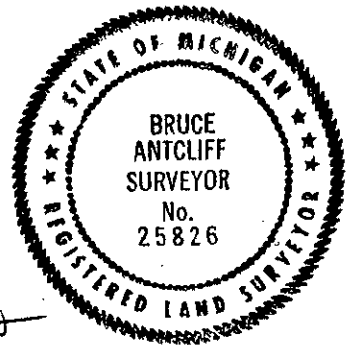

Signed by

Handwritten signature of Bruce Antcliff

Date 11-15-96

Surveyor's Michigan License No. 25826