

RATIFIED BY PEER GROUP
PA 345 OF 1990
MONROE COUNTY, MICHIGAN

LAND CORNER RECORDATION CERTIFICATE
Filing Requirement of Act 74, Mich. P.A. 1970

date: 8/10/1995
Recorded in: [Signature]
Monroe (58)
(County)

Located In: _____ Corner Code #H-3
T _____ R _____
T 8S R 6E
T _____ R _____
T _____ R _____
S _____ T _____ R _____
S _____ T _____ R _____
S _____ T _____ R _____
S _____ T _____ R _____
SURVEY & REMONUMENTATION
APR 04 1996

RECEIVED FOR RECORD
95 DEC 28 AM 9:06
STATE OF MICHIGAN
REGISTER OF DEEDS

Register of Deeds Stamp & File Number

4. Lot No. _____, Recorded Plat COMMISSION
5. Private Claims _____

	A	B	C	D	E	F	G	H	I	J	K	L
2	6	5	4	3	2	1						
3												
4	7	8	9	10	11	12						
5												
6	18	17	16	15	14	13						
7												
8	19	20	21	22	23	24						
9												
10	30	29	28	27	26	25						
11												
12	31	32	33	34	35	36						
13												

1995 REMONUMENTATION PROGRAM

I, G.B. WARNKE, JR., in a field survey on Oct. Dec., 1995, 19____, do hereby certify that under requirements of P.A. 74, Michigan P.A. of 1970, the corner points mentioned in lines 1 and 2 above were in conformance with regulations and rules therefore as required in the current manual of survey instructions of the United States Department of the Interior, Bureau of Land Management or by a decree of a Court of Law and/or that the corner points mentioned in lines 3, 4 and 5 above were in conformance with the rules of the Michigan Board of Land Surveyors or by a Decree of a Court of Law; established, re-established, monumented, re-monumented, recovered, found as expressed below:

NOTE: Not more than 4 corners, all in the same town and range, may be recorded on this certificate.

A. Description of original monument and accessories and/or subsequent restoration:

1/4 Corner common to Sections 3 & 10 / On Samaria Road on tarby surface
1820, GLO Surveyor, J. Wampler, set wood post - witnesses: W. Oak 5 S8E 23 & W. Oak 38 N16W 10.
1890, Willis Baldwin, stone at 1/4 corner S. side (Sec. 3) - witnesses: R. Oak 16 S71°E 106.
1893, A.F. Winney, S1/4 (Sec. 3) post - witnesses: Red Oak 14" S37 1/2E 1.07 & Cherry 8" N62 1/2 E 0.95.
1965, MSHD, N1/4 corner (Sec. 10). Stone & set 3/4" x 2' pipe. G.B. Warnke - 1972 Fd. 3/4" I.P. & 1978 I. pipe over stone & 1989 found iron pipe over stone & 1991-1992 set 1/2" x 8" pipe over found 1" pinch pipe as recorded in LCRC - Liber 3, Page 197 & Liber 3, Page 233.


B. Description of corner evidence found and/or method applied in restoring or reestablishing corner:

Found 1/2" iron pipe over stone. 8/10/1995 - corner was Peer Group approved.
10/24/95 G.B. Warnke crew set 1" x 36" iron pipe with brass remonumentation cap in monument box to replace 1/2" iron pipe over stone.

C. Description of monument for corner and accessories established to perpetuate locating the position of the corner:

Set 1" x 36" iron pipe with brass remonumentation cap in monument box and is accepted as the best available evidence of the position of the original corner and witnesses:
North 2° E 26.62 feet to found MSHD nail/shiner in east side of utility pole
East 2541.58 feet to (I-3) northeast corner of Section 10 as monumented by spike in pipe over stone recorded L.C.R.C., Liber 2, Page 451
South 2593.21 feet to (H-4) center of Section 10 as monumented by 1/2" iron pin in monument box recorded L.C.R.C., Liber 3, Page 233
West 2549.81 feet to (G-3) northwest corner of Section 10 as monumented by 1" iron pipe with remonumentation cap in monument box

Signed by [Signature] Date 12/19/1995
Surveyor's Michigan License No. 19474

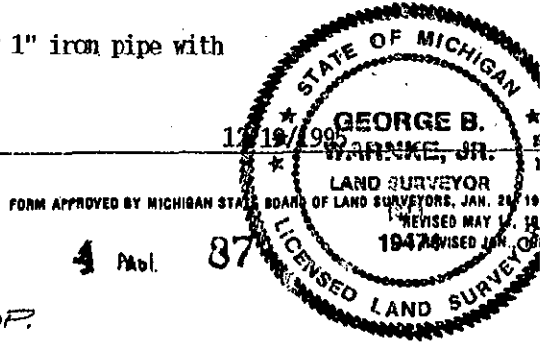

(13) H-3, T8S, R6E, WHITEFORD TWP.