

SURVEY & REMONUMENTATION

FEB 13 1998

SECTION

LAND CORNER RECORDATION CERTIFICATE
Filing Requirement of Act 74, Mich. P.A., 1970

For corners in

Monroe (58)
 (County)

Located In:

Corner Code #

WHITEFORD TWP.

- | | | |
|------------------------------------|-------------------------|------------|
| 1. Public Land Survey | T <u>8S</u> R <u>6E</u> | <u>I-6</u> |
| | T ___ R ___ | _____ |
| | T ___ R ___ | _____ |
| | T ___ R ___ | _____ |
| 2. Property Controlling in Section | S ___ T ___ R ___ | _____ |
| | S ___ T ___ R ___ | _____ |
| 3. Miscellaneous Property in Sec. | S ___ T ___ R ___ | _____ |
| | S ___ T ___ R ___ | _____ |

RECEIVED FOR RECORD
 97 DEC 30 PM 3:19
 REGISTER OF DEEDS
 MONROE COUNTY, MICH
George B. Warnke


Register of Deeds Stamp & File Number

4. Lot No. _____, Recorded Plat _____

5. Private Claims _____

1997 G.B. Warnke Private Remonumentation Corner

I, George B. Warnke, Jr., in a field survey on September 18, 1997 do hereby state that under requirements of P.A. 74, Michigan P.A. of 1970, the corner points mentioned in lines 1 and 2 above were in conformance with regulations and rules therefore as required in the current manual of survey instructions of the United States Department of the Interior, Bureau of Land Management or by decree of a Court of Law and / or that the corner points mentioned in lines 3, 4 and 5 above were in conformance with the rules of the Michigan Board of Land Surveyors or by a Decree of a Court of Law, established, re-established, monumented, recovered, found as expressed below:

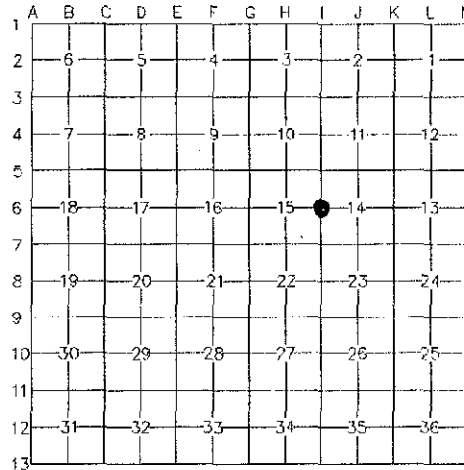

NOTE: Not more than 2 corners, all in the same town and range, may be recorded on this certificate.

- A. Description of original monument and accessories and/or subsequent restoration:
- 1820 GLO, Joseph Wampler, set the 1/2 mile post from which a Lynn 23 ins. dia. bears S36E 9 fks. dis. & a B. Walnut 8 ins. dia. bears N27W 35 fks. dis.
 - 1953 A.J. Marino notes show P. cap
 - 1957 Consumers Power notes show nail
 - 1972 Case & Fleck surveys note Found Spike & F. Spike
 - 1973 Meridith Freels survey notes R.R. spk. found
 - 1974 G.B. Warnke survey shows iron bolt
 - 1978 Case & Fleck survey shows Fd. bolt
 - 1981 G.B. Warnke survey shows iron bolt
 - 1988 G.B. Warnke survey shows found iron bolt
 - 1989 G.B. Warnke survey shows iron bolt
 - 1992 G.B. Warnke surveys show iron pin & found 1" iron bolt
- B. Description of corner evidence found and/or method applied in restoring or re-establishing corner:
- In 1997, G.B. Warnke set 1" x 36" iron pipe in monument box to replace found 1" hex bolt. During excavation, no other evidence was found.

RATIFIED BY PEER GROUP, PA 345 OF 1990, MONROE COUNTY, MICHIGAN, DATE 11/18/1997, COUNTY REP. *[Signature]*

12/1/1997 G.B. Warnke set brass remonumentation cap on previously set 1" x 36" pipe in monument box.

- C. Description of monument for corner and accessories established to perpetuate locating the position of the corner:
- Set 1" x 36" iron pipe with brass remonumentation cap in monument box to replace found 1" hex bolt and is accepted as the best available evidence of the position of the original corner. Witnesses:
- N85E 45.93' to found PK nail in west face of electric pole
 - N67W 89.02' to found PK nail in east face of utility pole
 - S50W 53.57' to found PK nail in east face of telephone pole
 - N30E 69.12' to found punch hole in east end of 12" CMP

Signed by *[Signature]*
 Surveyor's Michigan License No. 19474

Date 12/3/1997



FORM APPROVED BY MICHIGAN STATE BOARD OF LAND SURVEYORS, JAN. 28, 1
 REVISED MAY 14, 1
 REVISED JAN., 1
 REVISED OCT., 1