

# SURVEY & REMONUMENTATION

FEB 13 1998

## SECTION

### LAND CORNER RECORDATION CERTIFICATE Filing Requirement of Act 74, Mich. P.A., 1970

For corners in

Monroe (58)  
(County)

Located In:

Corner Code #

**WHITEFORD TWP.**

1. Public Land Survey

T8S R6E

1-7

T R

T R

T R

2. Property Controlling in Section

S T R

S T R

3. Miscellaneous Property in Sec.

S T R

S T R

4. Lot No. \_\_\_\_\_, Recorded Plat \_\_\_\_\_

5. Private Claims \_\_\_\_\_

#### 1997 G.B. Warnke Private Remonumentation Corner

I, George B. Warnke, Jr., in a field survey on September 18, 1997 do hereby state that under requirements of P.A. 74, Michigan P.A. of 1970, the corner points mentioned in lines 1 and 2 above were in conformance with regulations and rules therefore as required in the current manual of survey instructions of the United States Department of the Interior, Bureau of Land Management or by decree of a Court of Law and / or that the corner points mentioned in lines 3, 4 and 5 above were in conformance with the rules of the Michigan Board of Land Surveyors or by a Decree of a Court of Law; established, re-established, monumented, recovered, found as expressed below.

**NOTE: Not more than 2 corners, all in the same town and range, may be recorded on this certificate.**

#### A. Description of original monument and accessories and/or subsequent restoration:

1820 GLO, Joseph Wampler, set post corner of Secs. 14, 15, 22 & 23 from which an Elm \_\_\_ ins. dia. bears S3W 33 lks. dis. & a B. Oak 30 ins. dia. bears N9E 73 lks. dis.

1890 Willis Baldwin notes show stone

1951 A.J. Marino notes show set R.R. spk

1953 A.J. Marino notes show F. R.R. spike

1954 A.J. Marino notes show R.R. spike

1957 Consumers Power notes show R.R. spike

A.J. Marino survey shows F. spike

1962 A.J. Marino notes show F. R.R. spike

1972 A.J. Marino notes show P. R.R. spike

1973 Case & Fleck survey shows Fnd. Stone

Melvin Fleck LCRC shows Stone Found

Meridith Freels survey shows found stone

1974 G.B. Warnke survey shows set l. Bolt over stone

1975 A.J. Marino notes show F. Sq. Hd. bolt over stone

1988 G.B. Warnke survey shows found iron bolt over stone

1992 G.B. Warnke survey shows found 1" square iron bolt over stone

#### B. Description of corner evidence found and/or method applied in restoring or re-establishing corner:

In 1997, G.B. Warnke set 1" x 36" pipe in monument box to replace found 1" bolt over stone. During excavation, no other evidence was found.

**RATIFIED BY PEER GROUP, PA 345 OF 1990, MONROE COUNTY, MICHIGAN, DATE 11/18/1997, COUNTY REP.** 

12/3/1997, G.B. Warnke set brass remonumentation cap on previously set 1" x 36" pipe in monument box

#### C. Description of monument for corner and accessories established to perpetuate locating the position of the corner:

Set 1" x 36" pipe with brass remonumentation cap in monument box to replace found 1" bolt over stone and is accepted as the best available evidence of the position of the original corner. Witnesses:


S40W 49.35' to set nail in northwest face of telephone pole

N5E 31.97' to nail in west root of 18" Hickory

N30W 103.12' to southeast corner of resident foundation

S30E 86.55' to northwest corner of resident #5883

Signed by

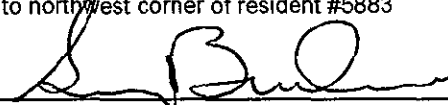

Surveyor's Michigan License No.

19474

Date 12/3/1997



RECEIVED FOR RECORD  
97 DEC 30 PM 3:20  
Peer Allen  
REGISTER OF DEEDS  
MONROE COUNTY, MICH.

Register of Deeds Stamp & File Number

	A	B	C	D	E	F	G	H	I	J	K	L	M
1													
2	6		5		4		3		2				
3													
4	7		8		9		10		11		12		
5													
6	13		17		16		15		14		13		
7													
8	19		20		21		22		23		24		
9													
10	30		29		28		27		26		25		
11													
12	31		32		33		34		35		36		
13													