

# SURVEY & REMONUMENTATION

FEB 13 1998

## SECTION

## LAND CORNER RECORDATION CERTIFICATE Filing Requirement of Act 74, Mich. P.A., 1970

For corners in

Monroe (58)  
(County)

Located In:

Corner Code #

WHITEFORD TWP.

1. Public Land Survey
2. Property Controlling in Section
3. Miscellaneous Property in Sec.

	T8S	R6E			
	T	R	_____	J-5	_____
	T	R	_____	_____	_____
	T	R	_____	_____	_____
	T	R	_____	_____	_____
	S	T	R	_____	_____
	S	T	R	_____	_____
	S	T	R	_____	_____
	S	T	R	_____	_____

RECEIVED FOR RECORD  
 97 DEC 30 PM 3:21  
 REGISTER OF DEEDS  
 MONROE COUNTY, MICH.  
*Handwritten Signature*


Register of Deeds Stamp & File Number

4. Lot No. \_\_\_\_\_, Recorded Plat \_\_\_\_\_

5. Private Claims \_\_\_\_\_

1997 G.B. Warnke Private Remonumentation Corner

I, George B. Warnke, Jr., in a field survey on September 19, 1997 hereby state that under requirements of P.A. 74, Michigan P.A. of 1970, the corner points mentioned in lines 1 and 2 above were in conformance with regulations and rules therefore as required in the current manual of survey instructions of the United States Department of the Interior, Bureau of Land Management or by decree of a Court of Law and / or that the corner points mentioned in lines 3, 4 and 5 above were in conformance with the rules of the Michigan Board of Land Surveyors or by a Decree of a Court of Law; established, re-established, monumented, recovered, found as expressed below:

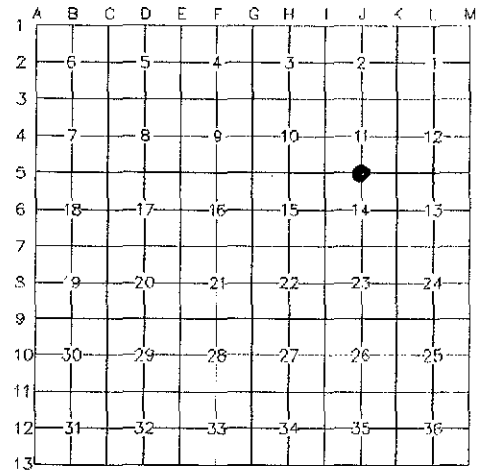

**NOTE:** Not more than 2 corners, all in the same town and range, may be recorded on this certificate.

- A. Description of original monument and accessories and/or subsequent restoration:
- 1820 GLO, Joseph Wampler, Corrected the line between Secs. No. 11 & 14 - Set the 1/4 sec. Post at the average dis. from which a W. Oak 32 ins. dia. bears S58E 53 lks. dis. & a W. Oak 18 ins. dia. bears N87W 95 lks. dis.
  - 1948 A.J. Marino notes - red granite stone
  - 1959 Case & Fleck survey - used corner - no materials noted
  - 1972 G.B. Warnke survey - Fd. 5/8" I. Pipe 0.5 below surface - G.B. Warnke was told by Mr. Hill, a long time resident on Erie Road, that a neighbor hit stone with his truck & pulled it out.
  - 1974 G.B. Warnke survey - Fd. 5/8" I. Pin
  - 1975 G.B. Warnke survey - 5/8" I. Pin
  - 1982 G.B. Warnke survey - 5/8" iron rod found
  - 1984 G.B. Warnke survey - Fd. 5/8" I. Pin
  - 1985 G.B. Warnke survey - 5/8" I. Pin
  - 1989 J.C. Andrus survey - Found existing recorded iron pin
  - 1994 G.B. Warnke found 5/8" rod

- B. Description of corner evidence found and/or method applied in restoring or re-establishing corner:
- In 1997, G.B. Warnke set 1" x 36" iron pipe in monument box to replace found 5/8" x 30" bar at surface. During excavation, dug a 24" x 24" hole and probed in all directions with no further evidence found. Corner is in Erie Road which is 1" tar chip over 9" stone mix over black sand.

**RATIFIED BY PEER GROUP, PA 345 OF 1990, MONROE COUNTY, MICHIGAN, DATE 11/18/1997, COUNTY REP.** *[Signature]*

12/1/1997, G.B. Warnke set brass remonumentation cap on previously set 1" x 36" pipe in monument box.

- C. Description of monument for corner and accessories established to perpetuate locating the position of the corner:
- Set 1" x 36" pipe with brass remonumentation cap in monument box to replace found 5/8" x 30" bar at surface and is accepted as the best available evidence of the position of the original corner. Witnesses:
- S10W 46.52' to found nail & shiner in east face of 12" Maple
  - S45W 70.92' to found nail & tag in northeast root of 18" Cottonwood
  - N75W 135.93' to found PK nail & shiner in south face of utility pole
  - N75E 99.35' to found PK nail & shiner in south face of telephone pole

Signed by *[Signature]*  
 Surveyor's Michigan License No. 19474

Date December 3, 1997



FORM APPROVED BY MICHIGAN STATE BOARD OF LAND SURVEYORS, JAN. 28, 1971  
 REVISED MAY 14, 1975  
 REVISED JAN., 1983  
 REVISED OCT., 1994