

**SURVEY &
REMONUMENTATION**

DEC 07 1994

**COMMISSION
LAND CORNER RECORDATION CERTIFICATE
Filing Requirement of Act 74, Mich. P.A. 1970**

RECEIVED FOR RECORD

94 OCT 12 PH 2: 35

Mari Allen
REGISTER OF DEEDS
MONROE COUNTY, MICH


Register of Deeds Stamp & File Number

RATIFIED BY PEER GROUP
PA 345 OF 1990
MONROE COUNTY, MICHIGAN
date: 8/9/1994
County Rep.: [Signature]
For corners in

<u>MONROE</u> (County)	Located In:	Corner Code #/
	WHITEFORD TWP.	
1. Public Land Survey	T <u>8</u> S <u>R</u> <u>6</u> E.	<u>K-7</u>
	T _____ R _____	_____
	T _____ R _____	_____
	T _____ R _____	_____
2. Property Controlling in Section	S _____ T _____ R _____	_____
	S _____ T _____ R _____	_____
3. Miscellaneous Property in Sec.	S _____ T _____ R _____	_____
	S _____ T _____ R _____	_____

4. Lot No. _____, Recorded Plat _____
5. Private Claims _____

1994 MONROE COUNTY REMONUMENTATION PROGRAM
Peer Group approved corner on 8/9/1994 per Act 345 of 1990.

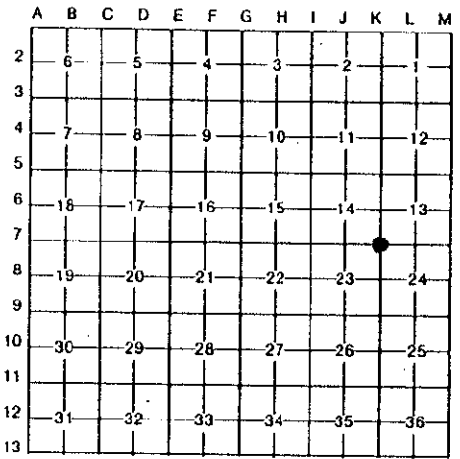


I, G.B. WARNKE, JR., in a field survey on 8/22/1994, 19____, do hereby certify that under requirements of P.A. 74, Michigan P.A. of 1970, the corner points mentioned in lines 1 and 2 above were in conformance with regulations and rules therefore as required in the current manual of survey instructions of the United States Department of the Interior, Bureau of Land Management or by a decree of a Court of Law and/or that the corner points mentioned in lines 3, 4 and 5 above were in conformance with the rules of the Michigan Board of Land Surveyors or by a Decree of a Court of Law; established, re-established, monumented, re-monumented, recovered, found as expressed below:

NOTE: Not more than 4 corners, all in the same town and range, may be recorded on this certificate.

A. Description of original monument and accessories and/or subsequent restoration:
K-7, T8S, R6E, Section Corner Common to Sections 13, 14, 23 & 24
(Intersection of Whiteford & Temperance Roads - tarby)
1820, G.L.O. Surveyor, Joseph Wampler, set post for corner Sections 13, 14, 23 & 24 and witnessed: Hickory 12 inch South 53° East 35 links and W. Oak 11 inch North 21° West 16 links. 1890, Willis Baldwin survey in Section 23, used west stone. 1902, Gard used east stone, survey in Section 13. Iron & stone fit plat of Whiteford Gardens, 1927, and appears to fit Section 13 (Gard). Marino set iron based on plat 1947 and 1956. 1971 & 1972 Fleck surveys use F.I.P. 1978, G.B. Warnke survey found bolt. Neither Baldwin nor Gard stated distances between stones. All known work in area uses the present corner. 1993, G.B. Warnke found bolt over stone, dug larger hole for more evidence, replaced with 1 inch x 18 inch iron pipe.

B. Description of corner evidence found and/or method applied in restoring or reestablishing corner:
K-7 - 7/31/1994 - Found iron pipe over high point of stone. Excavated stone under 1 inch iron pipe, broke large granite and left piece in on east side and drove 1 inch x 36 inch iron pipe at high point and placed broken pieces of granite around iron pipe at surface inside set monument box. 8/22/1994, set brass remonumentation cap on 1 inch x 36 inch iron pipe. Witnessed as shown below.

C. Description of monument for corner and accessories established to perpetuate locating the position of the corner:
K-7 - Set brass remonumentation cap on 1 inch x 36 inch iron pipe inside monument box and is accepted as the best available evidence of the position of the original corner and Witnesses:
South 35° West 45.95 feet nail & car coin in southeast face telephone pole
North 45° East 48.09 feet nail & shiner in southeast face utility pole
South 45° East 108.75 feet northwest corner of brick of house no. 8948
South 45° West 46.37 feet iron pipe in broken top concrete plat monument
East 6.5 feet centerline of Whiteford Road pavement
Found 1/2 inch iron pipe 0.6 feet east and 0.3 feet north

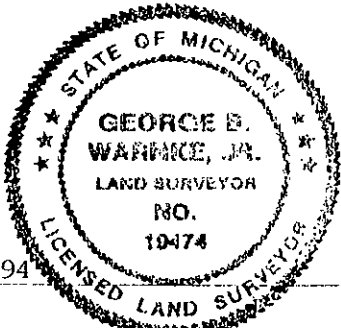

Signed by [Signature] Date 8/22/1994
Surveyor's Michigan License No. 19474