

**SURVEY &  
REMONUMENTATION**

DEC 07 1994

**COMMISSION  
LAND CORNER RECORDATION CERTIFICATE  
Filing Requirement of Act 74, Mich. P.A. 1970**

RECEIVED FOR RECORD  
94 OCT 12 PM 2:38

*Heri Allen*  
REGISTER OF DEEDS  
MONROE COUNTY, MICH

RATIFIED BY PEER GROUP  
PA 345 OF 1990  
MONROE COUNTY, MICHIGAN

date: 8-9-94

County Rep.: [Signature]

For corners in

<u>MONROE</u> <small>(County)</small>	Located In:	Corner Code #:
	WHITEFORD TWP.	
1. Public Land Survey	T <u>8</u> S R <u>6</u> E	<u>K-9</u>
	T _____ R _____	_____
	T _____ R _____	_____
	T _____ R _____	_____
2. Property Controlling in Section	S _____ T _____ R _____	_____
	S _____ T _____ R _____	_____
3. Miscellaneous Property in Sec.	S _____ T _____ R _____	_____
	S _____ T _____ R _____	_____

Register of Deeds Stamp & File Number

4. Lot No. \_\_\_\_\_, Recorded Plat \_\_\_\_\_  
5. Private Claims \_\_\_\_\_

1994 MONROE COUNTY REMONUMENTATION PROGRAM  
Peer Group approved on 8/9/1994 per Act 345 of 1990.

	A	B	C	D	E	F	G	H	I	J	K	L	M
2	6	5	4	3	2	1							
3													
4	7	8	9	10	11	12							
5													
6	18	17	16	15	14	13							
7													
8	19	20	21	22	23	24							
9													
10	30	29	28	27	26	25							
11													
12	31	32	33	34	35	36							
13													

I, G.B. WARNKE, JR., in a field survey on AUGUST 22, 1994, 19\_\_\_\_\_, do hereby certify that under requirements of P.A. 74, Michigan P.A. of 1970, the corner points mentioned in lines 1 and 2 above were in conformance with regulations and rules therefore as required in the current manual of survey instructions of the United States Department of the Interior, Bureau of Land Management or by a decree of a Court of Law and/or that the corner points mentioned in lines 3, 4 and 5 above were in conformance with the rules of the Michigan Board of Land Surveyors or by a Decree of a Court of Law; established, re-established, monumented, re-monumented, recovered, found as expressed below:


**NOTE: Not more than 4 corners, all in the same town and range, may be recorded on this certificate.**

**A. Description of original monument and accessories and/or subsequent restoration:**

K-9, T8S, R6E, Section Corner Common to Sections 23, 24, 25 & 26  
(Whiteford Rd. - north of Whiteford Center Rd. - 2 inch tarby & 6-8 inch stone base)  
G.L.O. Surveyor, Joseph Wampler in 1820 set post at corner of Sections 23, 24, 25 & 26, witnessed W.Oak 40 inches South 33° West 29 links & Hickory 18 inch North 44 links. 1890, Willis Baldwin notes southwest corner of Sec. 23 as stone & no witnesses near. 1971, Case & Fleck found stone, per survey recorded in Liber 627, Page 686 & recorded to stone in L.C.R.C., Liber 1, Page 141. 1971, A.J. Marino field notes indicate no point found & set PK. 1973, G.B. Warnke found stone, per survey recorded in Liber 647, Page 692. 1975, G.B. Warnke notes small bolt over stone, per Job File No. 75-24. 1977, Case & Fleck notes found iron over stone, per survey recorded in Liber 759, Page 884. 1978, James Fish recorded L.C.R.C., Liber 2, Page 280, to found R.R. spike. 1980 to 1993, G.B. Warnke notes iron over stone.

**B. Description of corner evidence found and/or method applied in restoring or reestablishing corner:**

K-9 - 8/3/1994 - Found 3/4 inch x 5 inch bolt at surface. 8 inch x 8 inch hollow top stone 12 inches long and 5 inches deep. Removed granite stone and found pieces of brick 20 to 24 inches deep under stone. May have found remains of post, but not sure, at 26 to 28 inches deep. Set 1 inch x 36 inch iron pipe with pieces of metal and brick around bottom and broke stone and placed pieces around pipe and set monument box at surface and on 8/22/94 set remonumentation cap on iron pipe and witnessed as shown below.

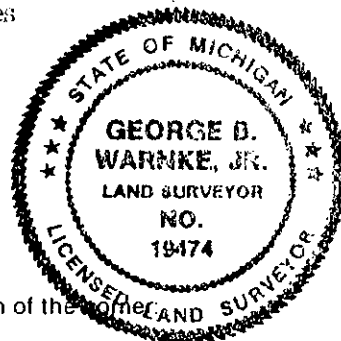

**C. Description of monument for corner and accessories established to perpetuate locating the position of the corner:**

K-9 - Set 1 inch x 36 inch black iron pipe with remonumentation cap inside monument box and is accepted as a careful and faithful perpetuation of the position of the original corner and Witnesses:  
North 80° West 87.40 feet southeast corner residence No. 8199  
West 27.48 feet found PK south face 36 inch Oak tree  
South 30° West 57.16 feet set nail/shiner northwest root 36 inch Oak tree  
North 40° East 41.47 feet found nail/shiner west face utility pole

Signed by [Signature]  
Surveyor's Michigan License No. 19474

Date August 9, 1994