

# SURVEY & REMONUMENTATION

FEB 13 1998

## SECTION

## LAND CORNER RECORDATION CERTIFICATE Filing Requirement of Act 74, Mich. P.A., 1970

For corners in

MONROE (58)  
(County)

Located In:

Corner Code #

Whiteford Twp.

T 8S R 6E

L-4

- 1. Public Land Survey
- 2. Property Controlling in Section
- 3. Miscellaneous Property in Sec.

T	_____	R	_____	_____
T	_____	R	_____	_____
T	_____	R	_____	_____
T	_____	R	_____	_____
S	_____	T	_____	_____
S	_____	T	_____	_____
S	_____	T	_____	_____
S	_____	T	_____	_____

RECEIVED FOR RECORD  
 97 DEC 30 PM 3:28  
 REGISTER OF DEEDS  
 MONROE COUNTY, MICH.  
*Howe*

Register of Deeds Stamp & File Number

4. Lot No. \_\_\_\_\_, Recorded Plat \_\_\_\_\_

5. Private Claims \_\_\_\_\_

**1997 G.B. WARNKE PRIVATE REMONUMENTATION CORNER**

I, George B. Warnke, Jr., in a field survey on September - December, 1997, do hereby state that under requirements of P.A. 74, Michigan P.A. of 1970, the corner points mentioned in lines 1 and 2 above were in conformance with regulations and rules therefore as required in the current manual of survey instructions of the United States Department of the Interior, Bureau of Land Management or by decree of a Court of Law and / or that the corner points mentioned in lines 3, 4 and 5 above were in conformance with the rules of the Michigan Board of Land Surveyors or by a Decree of a Court of Law; established, re-established, monumented, recovered, found as expressed below:

**NOTE: Not more than 2 corners, all in the same town and range, may be recorded on this certificate.**

A	B	C	D	E	F	G	H	I	J	K	L
1											
2	6		5		4		3		2		1
3											
4	7		8		9		10		11		12
5											
6	13		17		16		15		14		13
7											
8	19		20		21		22		23		24
9											
10	30		29		28		27		26		25
11											
12	31		32		33		34		35		36
13											

**A. Description of original monument and accessories and/or subsequent restoration:**

Centers not established by G.L.O.

1964 Michigan State Highway Department Witness Card notes - Center 1/4 cor. Sec. 12 - Found 3/4" pipe - witnesses: South 62.46' to a 13" Cherry / N65W 81.87' to a P.P. / N25E 33.24' to a T.P.

1965 Michigan State Highway Department Witness Card notes - Center Sec. No. 12 - Boat spike in Monument box - witnesses: N66W P.P. 81.93' / N22E T.P. 33.19' / S 13' Cherry 62.43'

1974 M.R. Fleck, Case & Fleck, Survey #18448 notes F. Mon (no witnesses)

1976 G.B. Warnke Survey #76-100 notes I. Pin in monument box - witnesses:

N20E 33.22 nail in E. face of tel. pole / S03E 31.60 nail in E. face of elec. pole / S50W 41.0 center of catch basin

1980 A.J. Marino survey notes center of Sec. 12 - Mon.

1995 & 1996 & 1997 G.B. Warnke Surveys #95-0061 & 96-0100 & 97-0051 note found iron pin in monument box - witnesses:

N20E 33.22' nail in E. face tele. pole / S03E 31.60' nail in E. face elec. pole / S50W 41.0' center of catch basin / S89°39'00" E 2602.31' found 1/2" iron pin in monument box at E 1/4 corner

**B. Description of corner evidence found and/or method applied in restoring or re-establishing corner:**

9/29/1997, G.B. Warnke crew found large bolt or boat spike in concrete in existing monument box being south of centerline joint & witnesses are in Section C.

**RATIFIED BY PEER GROUP, PA 345 OF 1990, MONROE COUNTY, MICHIGAN, DATE 10/14/1997, COUNTY REP.** *[Signature]*


12/18/1997, G.B. Warnke crew jackhammered around existing pin to remove some concrete and attached yellow plastic remonumentation cap to found bolt / spike in existing monument box.

**C. Description of monument for corner and accessories established to perpetuate locating the position of the corner:**

Attached yellow plastic remonumentation cap to found large bolt or boat spike or pin in concrete in existing monument box. This position was not established by original government surveyors. This monument is accepted as the best available evidence of the position of the corner. Witnesses: North 20° West 31.98 feet to seam in east face of GTE pedestal  
 North 20° East 37.9 feet to center of high point of red granite stone 30"  
 South 03° East 31.58 feet to found nail & shiner in East face of electric pole  
 South 45° West 40.93 feet to center hole in steel catch basin  
 North 05° West 67.32 feet to nail & brass remonumentation shiner in northeast face of electric pole  
 North 60° West 38.16 feet to nail & shiner in east face of tree

Signed by *[Signature]*  
 Surveyor's Michigan License No. 19474

Date December 19, 1997

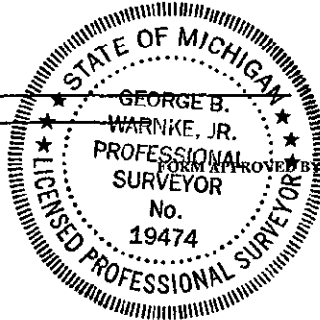

FORM APPROVED BY MICHIGAN STATE BOARD OF LAND SURVEYORS, JAN. 28, REVISED MAY 14, REVISED JAN., REVISED OCT.,