

**SURVEY &
REMONUMENTATION**

DEC 07 1994

RECEIVED FOR RECORD

RATIFIED BY PEER GROUP
PA 345 OF 1990
MONROE COUNTY, MICHIGAN

LAND CORNER RECORDATION CERTIFICATE
Filing Requirement of Act 74, Mich. P.A. 1970

94 OCT 12 PM 2:41

date: 8/19/1994
County Rep.: [Signature]
For corners in

Veri Allen
REGISTER OF DEEDS
MONROE COUNTY, MICH

MONROE (County) Located In: WHITEFORD TWP. Corner Code: L-7

1. Public Land Survey	T <u>8</u> S R <u>6</u> E	<u>L-7</u>
	T _____ R _____	_____
	T _____ R _____	_____
	T _____ R _____	_____
2. Property Controlling in Section	S _____ T _____ R _____	_____
	S _____ T _____ R _____	_____
3. Miscellaneous Property in Sec.	S _____ T _____ R _____	_____
	S _____ T _____ R _____	_____

Register of Deeds Stamp & File Number

4. Lot No. _____, Recorded Plat _____
5. Private Claims _____

1994 MONROE COUNTY REMONUMENTATION PROGRAM

Peer Group approved corner on 8/9/1994 per Act 345 of 1990.

I, G.B. WARNKE, JR., in a field survey on 8/23/1994, 19_____, do hereby certify that under requirements of P.A. 74, Michigan P.A. of 1970, the corner points mentioned in lines 1 and 2 above were in conformance with regulations and rules theretofore as required in the current manual of survey instructions of the United States Department of the Interior, Bureau of Land Management or by a decree of a Court of Law and/or that the corner points mentioned in lines 3, 4 and 5 above were in conformance with the rules of the Michigan Board of Land Surveyors or by a Decree of a Court of Law; established, re-established, monumented, re-monumented, recovered, found as expressed below:

	A	B	C	D	E	F	G	H	I	J	K	L	M
2	6		5		4		3		2		1		
3													
4	7		8		9		10		11		12		
5													
6	18		17		16		15		14		13		
7													
8	19		20		21		22		23		24		
9													
10	30		29		28		27		26		25		
11													
12	31		32		33		34		35		36		
13													

NOTE: Not more than 4 corners, all in the same town and range, may be recorded on this certificate.

A. Description of original monument and accessories and/or subsequent restoration:
L-7, T8S, R6E, 1/4 Corner Common to Sections 13 & 24

(Temperance Road being west of Whiteford Road)

1820, G.L.O. Surveyor, Joseph Wampler, set quarter Section post at average distance in marsh with no bearing trees. 1902, Harry R. Gard survey notes set stone and witnessed to highway bridge. 1972, Case & Fleck survey recorded in Liber 622, Page 327, notes S.I.P. (set iron pipe or pin). 1976, G.B. Warnke notes iron pin. Farnham, Moores & Wirries survey recorded in Liber 730, Page 396, notes 1/2 iron bar. 1993, G.B. Warnke excavated area and set 1 inch x 8 inch capped iron pipe inside 1 1/4 inch x 24 inch iron pipe over 1/2 inch rebar.


B. Description of corner evidence found and/or method applied in restoring or reestablishing corner:

L-7 - 10/25/1993 - Found railroad spike at surface, excavated area and found 1/2 inch rebar 9 inches below railroad spike. Probed to a depth of 4 feet from top of pavement with no further evidence found. Twin 8 foot diameter concrete pipes to east. Most westerly pipe is approximately 12.5 feet east of rebar and 14 feet between pipes. Set 1 inch x 8 inch capped iron pipe inside 1 1/4 inch x 24 inch iron pipe over 1/2 inch rebar and witnessed as shown below. 8/23/1994, set brass remonumentation cap on 1 inch x 36 inch black iron pipe inside monument box to replace previous points.

C. Description of monument for corner and accessories established to perpetuate locating the position of the corner:

L-7 - Set brass remonumentation cap on 1 inch x 36 inch black iron pipe inside monument box to replace previous points and is accepted as the best available evidence of the position of the original corner and Witnesses:

- North 05° West 32.04 feet nail/shiner in west face telephone pole
- North 15° East 35.17 feet chisled "+" in north end 8 foot diameter concrete pipe
- South 15° East 34.12 feet chisled "+" in south end 8 foot diameter concrete pipe
- South 60° West 101.20 feet nail/shiner in northeast face electric pole

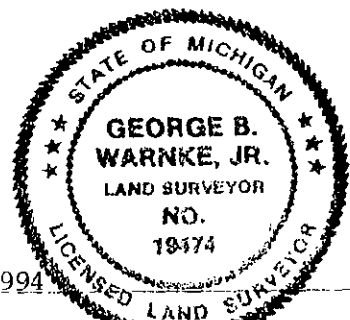

Signed by [Signature]
Surveyor's Michigan License No. 19474

Date 8/23/1994