

RATIFIED BY PEER GROUP
 PA 345 OF 1970
 MONROE COUNTY, MICHIGAN
 date: 10/18/1994
 County Rep. [Signature]

LAND CORNER RECORDATION CERTIFICATE
 Filing Requirement of Act 74, Mich. P.A. 1970

RECEIVED RECORDS
 95 FEB 28 AM 8:57

For corners in
 MONROE COUNTY - I.D. No. 58 Located In: Corner Code #
 (County)

- 1. Public Land Survey T ___ R ___
 WHITEFORD TWP. T 8S R 6E L-10
 T ___ R ___
 T ___ R ___
- 2. Property Controlling S ___ T ___ R ___
 in Section S ___ T ___ R ___
 3. Miscellaneous S ___ T ___ R ___
 Property in Sec. S ___ T ___ R ___

SURVEY &
 REMONUMENTATION

Register of Deeds Stamp & File Number

APR 04 1996

- 4. Lot No. _____, Recorded Plat _____
- 5. Private Claims _____ COMMISSION _____

	A	B	C	D	E	F	G	H	I	J	K	L	M
2	6		5		4		3		2		1		
3													
4	7		8		9		10		11		12		
5													
6	16		17		18		19		20		21		22
7													
8	19		20		21		22		23		24		
9													
10	30		29		28		27		26		25		
11													
12	31		32		33		34		35		36		
13													

GEORGE B. WARNKE, JR., P.S. & MONROE COUNTY ROAD COMMISSION CORNER
 BRUCE ANTCLIFF 1995

I, G.B. WARNKE, JR., in a field survey on 1994 & 1995, 19 do hereby certify that under requirements of P.A. 74, Michigan P.A. of 1970, the corner points mentioned in lines 1 and 2 above were in conformance with regulations and rules therefore as required in the current manual of survey instructions of the United States Department of the Interior, Bureau of Land Management or by a decree of a Court of Law and/or that the corner points mentioned in lines 3, 4 and 5 above were in conformance with the rules of the Michigan Board of Land Surveyors or by a Decree of a Court of Law; established, re-established, monumented, re-monumented, recovered, found as expressed below:

NOTE: Not more than 4 corners, all in the same town and range, may be recorded on this certificate.

A. Description of original monument and accessories and/or subsequent restoration:

L-10, T8S, R6E, Whiteford Township, Monroe County - ID No. 58 Center of Section 25
 (Clegg and Corey Roads, 1/2 mile west of Adler Road - 1" tarby over 12" stone over mixed stone)
 Earliest notes found in J.W. White, Book No. 35, Page 22, to stone June 25, 1925. Plat of Walnut Grove Place was recorded, August 1925, in Liber 6, Page 25. In 1974, G.B. Warnke found large nail over stone to southeast. G.B. Warnke used this corner for several surveys. Corner was recorded by G.B. Warnke, March 30, 1987, in L.C.R.C., Liber 3, Page 28. Another iron pipe was also used by others 8.02 feet to the southwest and appeared in 1966 A.J. Marino notes as found. This iron was raised with a 1/2 inch iron pipe and again included as witness to the (stone) center of Section. In September 1994, the stone was rewitnessed to a 1 inch x 24 inch iron pipe over stone to be placed in monument box by the Monroe County Road Commission after Clegg Road is repaved.

B. Description of corner evidence found and/or method applied in restoring or reestablishing corner:


9/22/1994, found 3/4" iron pipe 0.9 feet deep. Dug 18" x 24" diameter hole 5 foot north of centerline of Clegg Road, found 3/4" iron pipe at 0.9 feet deep, iron pipe is drove in along easterly edge of stone, then leaning over granite stone with small (4 to 5 inch) stone surrounding it. Set 1" x 24" iron pipe at center of stone and compacted area. Found another 3/4" iron pipe 1 foot +/- 8.02 feet South 40° West this corner was apparently used as center of Section for surveys in North 1/2 of this Section to Whiteford Center Road. Raised this iron to surface with a 1/2 inch iron pipe. Corner fits plat Walnut Grove Place, Liber 6, Page 15. Set 1" iron pipe over stone. Witnesses from Book 35, Page 22, are gone as are witnesses from 1974 survey and witnessed as shown below. 1995, set 1" x 36" iron pipe with brass remonumentation cap inside monument box to replace iron pipe over stone.

C. Description of monument for corner and accessories established to perpetuate locating the position of the corner:

Set 1" x 36" iron pipe with brass remonumentation cap inside monument box and this position not established by original government surveyors and this monument is accepted as the best available evidence of the position of the corner and witnesses:
 South 35° East 36.18 feet to nail in southwest face guy pole
 South 35° West 46.73 feet to chisel cut top in west end 12 inch concrete pipe
 North 10° West 29.50 feet to nail in west face telephone pole
 North 65° West 67.43 feet D.H. nail and shiner in south face 15 inch Walnut
 North 70° West 82.52 feet in easterly face of 1-1/2 inch x 18 inch iron pipe, property corner

Signed by Bruce Antcliff
 Surveyor's Michigan License No. 25826

Date 12-22-95

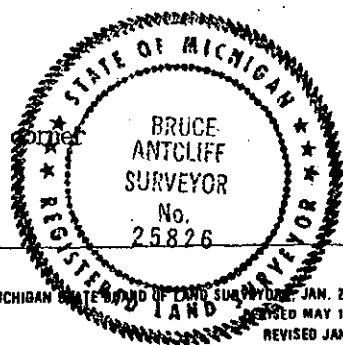

FORM APPROVED BY MICHIGAN BOARD OF LAND SURVEYORS JAN. 28, 1971
 REVISED MAY 14, 1975
 REVISED JAN., 1983

GEORGE B. WARNKE, JR., P.S. & MONROE COUNTY ROAD COMMISSION CORNER