

RATIFIED BY PEER GROUP
PA 345 OF 1930
MONROE COUNTY, MICHIGAN

date: 11/28/1995

LAND CORNER RECORDATION CERTIFICATE
Filing Requirement of Act 74, Mich. P.A. 1970

County Rep.: [Signature]

For corners in

Monroe (58)

(County)

Located In:

Corner Code #

- | | | | |
|------------------------------------|---|---|-----|
| 1. Public Land Survey | T | R | |
| WHITEFORD TWP. | T | R | M-3 |
| | T | R | |
| | T | R | |
| 2. Property Controlling in Section | S | T | R |
| | S | T | R |
| 3. Miscellaneous Property in Sec. | S | T | R |
| | S | T | R |



RECEIVED FOR RECORDS
95 DEC 29 AM 9:06

Register of Deeds Stamp & File Number

4. Lot No. _____, Recorded Plat APR 04 1996

5. Private Claims _____

COMMISSION

1995 REMONUMENTATION PROGRAM

I, G.B. WARNKE, JR., in a field survey on Oct. Dec. 1995, 19____, do hereby certify that under requirements of P.A. 74, Michigan P.A. of 1970, the corner points mentioned in lines 1 and 2 above were in conformance with regulations and rules therefore as required in the current manual of survey instructions of the United States Department of the Interior, Bureau of Land Management or by a decree of a Court of Law and/or that the corner points mentioned in lines 3, 4 and 5 above were in conformance with the rules of the Michigan Board of Land Surveyors or by a Decree of a Court of Law; established, re-established, monumented, re-monumented, recovered, found as expressed below:

NOTE: Not more than 4 corners, all in the same town and range, may be recorded on this certificate.


	A	B	C	D	E	F	G	H	I	J	K	L	M
2	6	5	4	3	2	1							
3													
4	7	8	9	10	11	12							
5													
6	18	17	16	15	14	13							
7													
8	19	20	21	22	23	24							
9													
10	30	29	28	27	26	25							
11													
12	31	32	33	34	35	36							
13													

A. Description of original monument and accessories and/or subsequent restoration:

Section Corner common to Sections 1 & 12 / On north side of Samaria Road - not in road. 1820, GLO Surveyor, J. Wampler, set post cor. of sect. 1 & 12 - witnesses: B. Oak 16 S47E 16 & W. Oak 12 N21W 36. 1900, Chas. Kirby notes stone at SE corner of Sec. 1. 1900, J. VanDeventer notes stone at SE corner of Sec. 1. 1925, J.W. White notes stone at SE corner of Sec. 1. 1973, G.B. Warnke, Job #73-2, Liber 639, Page 846, & Job #73-21, Liber 643, Page 447, to FD. I. PIN. 1981, G.B. Warnke (#80-144) found stone & in 1989 recorded LCRC, Liber 3, Page 69, to FOUND STONE & tied in "T" iron being South 45° East 2.15 feet.

B. Description of corner evidence found and/or method applied in restoring or reestablishing corner:

10/25/1995 - G.B. Warnke crew found stone 1 foot below the surface - no other evidence found. Replaced stone with 1" x 36" iron pipe and broke stone & placed pieces around base of iron.
12/5/1995 - placed brass remonumentation cap on iron pipe.

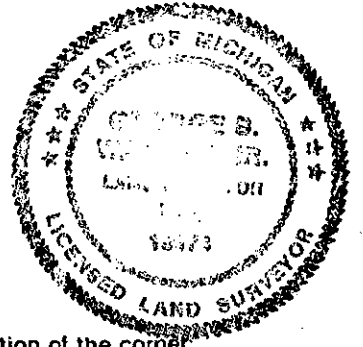

C. Description of monument for corner and accessories established to perpetuate locating the position of the corner:

Set 1" x 36" iron pipe with brass remonumentation cap and is accepted as the best available evidence of the position of the original corner and witnesses:
South 1° East 79.20 feet to nail/shiner in west face of telephone pole
South 20° West 80.23 feet to nail/shiner in westerly root of 19" Ash
South 10° East 4.23 feet to the northwest corner of 2' x 2' brick pillar
East 8.88 feet to west face of 13" Red pine
East 2.10 feet to split rail wood fence to north & south
South 45° East 2.15 feet to found "T" iron
South 92.21 feet to A-3, T8S, R7E, as monumented by brass remonumentation cap on 1" x 36" iron pipe
South +/- 65 feet to centerline of Samaria Road

Signed by [Signature] Date 12/19/1995
Surveyor's Michigan License No. 19474

① M-3 T8S, R7E, WHITEFORD TWP 4 Pgs 88