

SURVEY & REMONUMENTATION

DEC 07 1994

COMMISSION

RATIFIED BY PEER GROUP PA 345 OF 1990 MONROE COUNTY, MICHIGAN

LAND CORNER RECORDATION CERTIFICATE Filing Requirement of Act 74, Mich. P.A. 1970

RECEIVED FOR RECORD

94 OCT 12 PM 2:42

date: 8-23-94 County Rep. For corners in

Handwritten signature: Teri Allen REGISTER OF DEEDS MONROE COUNTY, MICH.

MONROE (County)

Located In: Corner Code ##

WHITEFORD TWP.

Table with 3 columns: Description, Located In (T/S), Corner Code (R/E). Includes Public Land Survey, Property Controlling in Section, and Miscellaneous Property in Sec.

Register of Deeds Stamp & File Number

4. Lot No. , Recorded Plat

5. Private Claims

1994 MONROE COUNTY REMONUMENTATION PROGRAM

Peer Group approved corner on 8/23/1994 per Act 345 of 1990.

Grid table with columns A-M and rows 2-13. Contains numbers 1-36.

G.B. WARNKE, JR. in a field survey on AUGUST 23, 1994 do hereby certify that under requirements of P.A. 74, Michigan P.A. of 1970, the corner points mentioned in lines 1 and 2 above were in conformance with regulations and rules therefor as required in the current manual of survey instructions of the United States Department of the Interior, Bureau of Land Management or by a decree of a Court of Law and/or that the corner points mentioned in lines 3, 4 and 5 above were in conformance with the rules of the Michigan Board of Land Surveyors or by a Decree of a Court of Law, established, re-established, monumented, re-monumented, recovered, found as expressed below:

NOTE: Not more than 4 corners, all in the same town and range, may be recorded on this certificate.

A. Description of original monument and accessories and/or subsequent restoration:


M-9, T8S, R6E, East Section Corner Common to Sections 24 & 25 (On Adler Road - 1/2 Mile South of Consear Road) (Also A-9, T8S, R7E - Approved in 1993) 1820, G.L.O. Surveyor Joseph Wampler went north on west range line of T8S R7E set post corner Sections 24 & 25, T8S, R6E. Witnesses: B. Oak 8 inch S.71°E. 64 links & B. Oak 17 inch S.43°W. 94 links. / No old evidence found in files. / Corner is common corner to Sections 24 & 25, (M-9) T8S, R6E. / Angelo J. Marino & G.B. Warnke surveys refer to 5/8 inch iron rod. / G.B. Warnke records iron rod in L.C.R.C., Liber 3, Page 66.

B. Description of corner evidence found and/or method applied in restoring or reestablishing corner:

M-9 - On 10/28/1993, found 3/4 inch iron rod. On 8/23/1994, replaced rod with set 1 inch x 36 inch black iron pipe with remonumentation cap inside monument box and witnessed as shown below.

C. Description of monument for corner and accessories established to perpetuate locating the position of the corner:

M-9 - Set 1 inch x 36 inch black iron pipe with remonumentation cap inside monument box and is accepted as the best available evidence of the position of the original corner and witnesses: South 87° East 31.43' found nail/shiner in north face of utility pole North 30° West 73.76' found nail/shiner in southeast face of electric pole West 33.00' found 3/4 inch iron rod West 32.42' found nail/shiner in north face of post South 25° West 105.75' found nail/shiner in north face of electric pole South 35° East 55.85' found nail/shiner in west face of 36 inch Maple

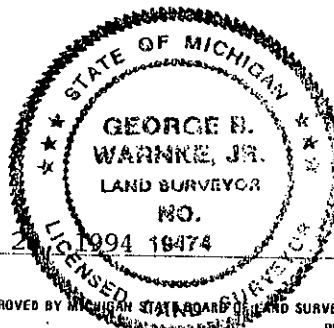

Signed by [Signature] Surveyor's Michigan License No. 19474

Date AUGUST 23, 1994

3 376