

RATIFIED BY PEER GROUP
PA 345 OF 1990
MONROE COUNTY, MICHIGAN

date: 10/24/1995

County Rep.: [Signature]

LAND CORNER RECORDATION CERTIFICATE
Filing Requirement of Act 74, Mich. P.A. 1970

For corners in
Monroe (58)

| (County) | Located In: | Corner Code # |
|---|---|------------------------|
| 1. Public Land Survey WHITEFORD TWP. | T <u>8S</u> R <u>6E</u> | <u>M-13</u> |
| 2. Property Controlling in Section | S <u> </u> T <u> </u> R <u> </u> | <u>SURVEY &</u> |
| 3. Miscellaneous Property in Sec. | S <u> </u> T <u> </u> R <u> </u> | <u>REMONUMENTATION</u> |

RECEIVED FOR RECORD
 95 DEC 29 AM 9:06
 REGISTER OF DEEDS
 MONROE COUNTY, MICHIGAN

Register of Deeds Stamp & File Number

APR 04 1996

4. Lot No. _____, Recorded Plat _____
 5. Private Claims _____ **COMMISSION**
 1995 REMONUMENTATION PROGRAM
 Peer Group approved 10/24/95 per Act 345

| | A | B | C | D | E | F | G | H | I | J | K | L |
|----|----|----|----|----|----|---|---|---|---|---|---|---|
| 2 | 6 | 5 | 4 | 3 | 2 | | | | | | | |
| 3 | | | | | | | | | | | | |
| 4 | 7 | 8 | 9 | 10 | 11 | | | | | | | |
| 5 | | | | | | | | | | | | |
| 6 | 18 | 17 | 16 | 15 | 14 | | | | | | | |
| 7 | | | | | | | | | | | | |
| 8 | 19 | 20 | 21 | 22 | 23 | | | | | | | |
| 9 | | | | | | | | | | | | |
| 10 | 30 | 29 | 28 | 27 | 26 | | | | | | | |
| 11 | | | | | | | | | | | | |
| 12 | 31 | 32 | 33 | 34 | 35 | | | | | | | |
| 13 | | | | | | | | | | | | |

I, G.B. WARNKE, JR., in a field survey on 1994 & 1995, 19____ do hereby certify that under requirements of P.A. 74, Michigan P.A. of 1970, the corner points mentioned in lines 1 and 2 above were in conformance with regulations and rules therefore as required in the current manual of survey instructions of the United States Department of the Interior, Bureau of Land Management or by a decree of a Court of Law and/or that the corner points mentioned in lines 3, 4 and 5 above were in conformance with the rules of the Michigan Board of Land Surveyors or by a Decree of a Court of Law; established, re-established, monumented, re-monumented, recovered, found as expressed below:

NOTE: Not more than 4 corners, all in the same town and range, may be recorded on this certificate.

A. Description of original monument and accessories and/or subsequent restoration:

Southeast corner of Section 36 and Township, T8S, R6E / At Smith Road & Pelton Drive in pavement (Common Corners: A-1, T9S, R7E & A-13, T8S, R7E & M-13, T8S, R6E & M-1, T9S, R6E) 1820, G.L.O. Surveyor, Joseph Wampler, set post at corner of Township 8 & 9 South, Range 6 & 7 South - witnesses: B. Oak 18 N.45W. 4 lks & B. Oak 11 S.31E. 54 lks. / Old survey book notes stone, Surveyor unknown. / J. Duszynski surveys recorded in Liber 628, Page 732 & Liber 622, Page 186, notes FND. STONE. 1973, Farnham, Moores & Wirries, #73-28, notes RR SPIKE. 1989, G.B. Warnke, Job #89-708, notes FOUND P.K. NAIL. 10/1993, found 5/8 inch x 9 1/2 inch small engine shaft over stone being approximately 8 inches deep. 12/1994, set 1" x 36" iron pipe with brass remonumentation cap inside monument box.


B. Description of corner evidence found and/or method applied in restoring or reestablishing corner:

10/1995 - checked point and witnesses per LCRC's for A-13, T8S, R7E, & A-1, T9S, R7E, which is a common corner. Rechecked found 1" iron pipe with brass remonumentation cap in monument box.

C. Description of monument for corner and accessories established to perpetuate locating the position of the corner:

FOUND
 set 1" x 36" iron pipe with brass remonumentation cap in monument box and is accepted as the best evidence of the position of the corner and witnesses:
 S40°W 74.65' northeast corner of foundation of house No. 4301
 S45°W 40.13' found nail/shiner in northeast face of telephone pole
 N60°W 60.33' found P.K. nail/shiner in southwest face of telephone pole
 N15°E 86.09' southwest corner of siding on attached garage at house No. 4298 (previous witness to foundation, now broken)
 S10°E 29.75' found nail/shiner in northerly face of 30" Oak
 N60°E 83.55' found P.K. nail/shiner in southeast face of utility pole

Signed by [Signature] Date 11/30/1995
 Surveyor's Michigan License No. 19474

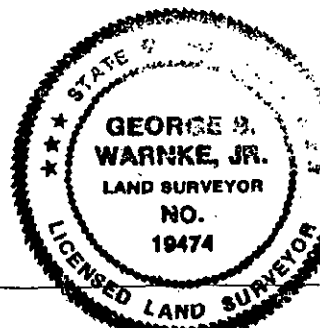

FORM APPROVED BY MICHIGAN STATE BOARD OF LAND SURVEYORS, JAN. 28, 197
 REVISED MAY 14, 197
 REVISED JAN., 198

⑧ M-13, T8S, R6E, WHITEFORD Twp