

RATIFIED BY PEER GROUP
 PA 345 OF 1990
 MONROE COUNTY, MICHIGAN
 date: 11/22/1994
 County Rep: [Signature]

LAND CORNER RECORDATION CERTIFICATE
 Filing Requirement of Act 74, Mich. P.A. 1970

For corners in

MONROE COUNTY
 (County)

Located In:

Corner Code #

1. Public Land Survey
 BEDFORD TWP. T 8S R 7E A-10
2. Property Controlling
 in Section S T R SURVEY &
 S T R REMONUMENTATION
3. Miscellaneous
 Property in Sec. S T R

Register of Deeds Stamp & File Number

APR 04 1996

4. Lot No. _____, Recorded Plat _____
5. Private Claims _____ COMMISSION

GEORGE B. WARNKE, JR., P.S. & M.C.R.C. CORNER

BRUCE ANTCLIFF 1995

I, G.B. WARNKE, JR. in a field survey on 1994 & 1995, 19 _____, do hereby certify that under requirements of P.A. 74, Michigan P.A. of 1970, the corner points mentioned in lines 1 and 2 above were in conformance with regulations and rules therefore as required in the current manual of survey instructions of the United States Department of the Interior, Bureau of Land Management or by a decree of a Court of Law and/or that the corner points mentioned in lines 3, 4 and 5 above were in conformance with the rules of the Michigan Board of Land Surveyors or by a Decree of a Court of Law; established, re-established, monumented, re-monumented, recovered, found as expressed below:

NOTE: Not more than 4 corners, all in the same town and range, may be recorded on this certificate.

	A	B	C	D	E	F	G	H	I	J	K	L
2	6	5	4	3	2	1						
3												
4	7	8	9	10	11	12						
5												
6	18	17	16	15	14	13						
7												
8	19	20	21	22	23	24						
9												
10	30	29	28	27	26	25						
11												
12	31	32	33	34	35	36						
13												

A. Description of original monument and accessories and/or subsequent restoration:


A-10, T8S, R7E, Bedford Township, (Adler & Clegg Roads - asphalt)
 West 1/4 Corner Common to Sections 30 (used as common corner with M-10, T8S, R6E)
 G.L.O. Surveyor did not set point. A prorated distance between A-9 & A-11 would be 42.3 feet north of a found 1 inch iron pipe. 1974, G.B. Warnke looked extensively for this corner and east 1/4 corner of Section 25, T8S, R6E. This 1 inch iron pipe has been used as both corners on most known surveys by many surveyors.

B. Description of corner evidence found and/or method applied in restoring or reestablishing corner:

9/22/1994, found 6 inch boat spike being 1 inch below surface. Dug a 18 inch x 38 inch hole and found a 1 inch O.D. iron pipe at 12 inches deep driven inside an inch I.D. x 36 inch iron pipe. Probed - no stone, post or further evidence found. Set 1 inch iron pipe inside monument box replacing boat spike and iron pipe and need to set brass remonumentation cap and witnessed as shown below.
 11/ 8/1995, set brass remonumentation cap on 1 inch iron pipe.

C. Description of monument for corner and accessories established to perpetuate locating the position of the corner:

Set 1 inch iron pipe with brass remonumentation cap inside monument box and this position was not established by original government surveyors and this monument is accepted as the best available evidence of the position for corner A-10, but recognizes the position as being 42.3 feet south of the proposed position and witnesses:
 North 30° East 33.80 feet to nail in southeast face of twin Oak
 South 30° East 27.55 feet to nail in north face of telephone pole

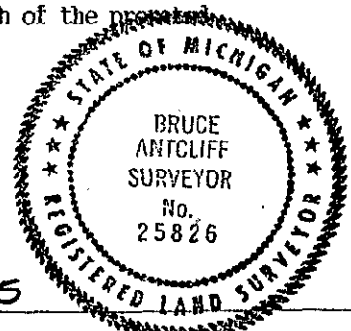

Signed by Bruce Antcliff Date 12-22-95
 Surveyor's Michigan License No. 25826