

# SURVEY & REMONUMENTATION

APR 28 1995

## COMMISSION

**LAND CORNER RECORDATION CERTIFICATE**  
**Filing Requirement of Act 74, Mich. P.A. 1970**

RECEIVED FOR RECORD  
94 DEC 29 AM 11:03

*Peri Allen*  
REGISTER OF DEEDS  
MONROE COUNTY, MICH

**RATIFIED BY PEER GROUP**  
PA 345 OF 1990  
MONROE COUNTY, MICHIGAN  
date: 10/26/1993  
County Rep. For corners in: [Signature]  
MONROE  
(County)

Located in: BEDFORD TWP. Corner Code # A-13

1. Public Land Survey	T	8 S	R	7 E	A-13
	T		R		
	T		R		
	T		R		
2. Property Controlling in Section	S		T	R	
	S		T	R	
3. Miscellaneous Property in Sec.	S		T	R	
	S		T	R	

Register of Deeds Stamp & File Number

4. Lot No. \_\_\_\_\_, Recorded Plat \_\_\_\_\_  
5. Private Claims \_\_\_\_\_

	A	B	C	D	E	F	G	H	I	J	K	L	M
2	6	5	4	3	2	1							
3													
4	7	8	9	10	11	12							
5													
6	18	17	16	15	14	13							
7													
8	19	20	21	22	23	24							
9													
10	30	29	28	27	26	25							
11													
12	31	32	33	34	35	36							
13													

MONROE COUNTY REMONUMENTATION PROGRAM Peer Group approved corner on 10-26-1993 per Act. 345 of 1990.

I, G.B. WARNKE, JR., in a field survey on 12/13, 1994, do hereby certify that under requirements of P.A. 74, Michigan P.A. of 1970, the corner points mentioned in lines 1 and 2 above were in conformance with regulations and rules therefore as required in the current manual of survey instructions of the United States Department of the Interior, Bureau of Land Management or by a decree of a Court of Law and/or that the corner points mentioned in lines 3, 4 and 5 above were in conformance with the rules of the Michigan Board of Land Surveyors or by a Decree of a Court of Law; established, re-established, monumented, re-monumented, recovered, found as expressed below:

**NOTE: Not more than 4 corners, all in the same town and range, may be recorded on this certificate.**

**A. Description of original monument and accessories and/or subsequent restoration:**

A-13, T8S, R7E, Southwest Township Corner, &/or Southwest corner of Section 31 G.L.O. Surveyor Joseph Wampler set post at corner of Township 8 & 9 South, Range 6 & 7 South. Witnesses: B. Oak 18 inch N.45°W. 4 links, B. Oak 11 inch S.31°E. 54 links. / Old book notes stone (Book 14, Page 20), Surveyor unknown. / M.R. Fleck in December of 1946, 1955, and 1973 witnessed stone with railroad spike above. / Corner has been used by George B. Warnke and area surveyors as presently monumented by a "T" iron leaning over stone and witnessed. / Corner recorded in December of 1975 by Roland Jackson, R.L.S. #22413, in L.C.R.C., Liber 2, Page 120. (common with A-1, T9S, R7E)


**B. Description of corner evidence found and/or method applied in restoring or reestablishing corner:**

A-13 - 10/26/1993, found 5/8 inch x 9 1/2 inch small engine shaft over stone being approximately 8 inches deep and witnessed as shown below. 12/13/1994, set 1 inch x 36 inch iron pipe with brass remonumentation cap in monument box to replace engine shaft over stone.

**C. Description of monument for corner and accessories established to perpetuate locating the position of the corner:**

Set 1 inch x 36 inch iron pipe with brass remonumentation cap in monument box to replace A-13 - 10/26/1993, found 5/8 inch x 9 1/2 inch small engine shaft over stone being approximately 8 inches deep and is accepted as a careful and faithful perpetuation of the position of the original corner and witnesses:  
S40°W 74.65' northeast corner of foundation of house No. 4301  
S45°W 40.13' found nail/shiner in northeast face of telephone pole  
N60°W 60.33' found P.K. nail/shiner in southwest face of telephone pole  
N15°E 86.09' southwest corner of siding on attached garage at house No. 4298 (previous witness to foundation, now broken)  
S10°E 29.75' found nail/shiner in northerly face of 30" Oak  
N60°E 83.55' found P.K. nail/shiner in southeast face of utility pole

Signed by [Signature] Date 12/13/1994  
Surveyor's Michigan License No. 19474

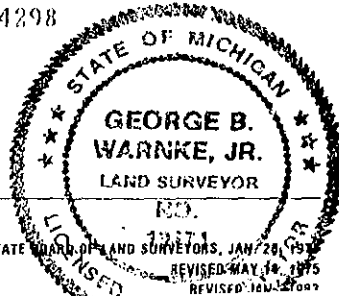

FORM APPROVED BY MICHIGAN STATE BOARD OF LAND SURVEYORS, JAN/28/95  
REVISED MAY 18, 1995