

NOV 02 2000

LAND CORNER RECORDATION CERTIFICATE
Filing Requirement of Act 74, Mich. P.A. 1970

RECEIVED FOR RECORD

96 DEC 27 PM 2:25

For corners in SECTION

MONROE (58)

(County)

Located In:

Corner Code ##

1996 REMONUMENTATION PROGRAM

1. Public Land Survey

T ___ R ___

T ___ R ___

BEDFORD TWP.

T 8S R 7E

C-6

T ___ R ___

2. Property Controlling in Section

S ___ T ___ R ___

S ___ T ___ R ___

3. Miscellaneous

S ___ T ___ R ___

Property in Sec.

S ___ T ___ R ___

4. Lot No. _____, Recorded Plat _____

5. Private Claims _____

1/4 Section Corner to Sections 17 & 18

On Secor Road (paved) between Erie & Temperance Rds

I, G.B. WARNKE, JR., in a field survey on 1996, do hereby certify that under requirements of P.A. 74, Michigan P.A. of 1970, the corner points mentioned in lines 1 and 2 above were in conformance with regulations and rules therefore as required in the current manual of survey instructions of the United States Department of the Interior, Bureau of Land Management or by a decree of a Court of Law and/or that the corner points mentioned in lines 3, 4 and 5 above were in conformance with the rules of the Michigan Board of Land Surveyors or by a Decree of a Court of Law; established, re-established, monumented, re-monumented, recovered, found as expressed below:

NOTE: Not more than 4 corners, all in the same town and range, may be recorded on this certificate.

A. Description of original monument and accessories and/or subsequent restoration:

1820, GLO Surveyor, J. Wampler, set qr. Sec. post - witnesses: B. Oak 20 inches N.10° W. 47 links & W. Oak 16 inches West 95 links.

Early 1900's, old book notes stone & 2 witnesses;

Early 1900's, 2 witness cards note "stone found" & witnesses: 1.5' S. of fence line to W. & 30' E. of W. fence post;

11/7/55, Case & Fleck(?) or A.J. Marino, field notes show set bolt.

11/70, M.R. Fleck (witness card) notes spike above iron plug and witnesses:

S15°E 63.55' to P. pole & N30°E 90.43' to 1st large tree, with nail section A continued on reverse side

B. Description of corner evidence found and/or method applied in restoring or reestablishing corner:

11/4/1993, found railroad spike 3 inches deep over 5/8 inch x 4 inches long square head bolt 3 1/2 inches deep under head (lip) of railroad spike. Dug 1 1/2 feet deep and probed 3 foot in all directions but found no other evidence. Set 1 1/4 inch by 24 inch capped iron pipe (No. 19474) in place of railroad spike and bolt.

1996, found iron pipe as set in 1993 and checked witnessed as shown below.

6/11/96, corner approved by Remonumentation Peer Group.

12/16/96, pulled 1 1/4" pipe and replaced with set 1" x 36" iron pipe with brass remonumentation cap in monument box & witnesses as shown below.

RATIFIED BY PEER GROUP
PA 345 OF 1990
MONROE COUNTY, MICHIGAN

date: 6/11/1996

County Rep.: [Signature]

C. Description of monument for corner and accessories established to perpetuate locating the position of the corner:

Set 1" x 36" iron pipe with brass remonumentation cap in monument box to replace previous monumentation and is accepted as the best available evidence of the position of the original corner and witnesses:

South 20° East 88.24 feet to found PK nail/shiner in easterly face of utility pole


South 40° West 60.18 feet to set nail/shiner in easterly face of 18 inch Pine

West 33.10 feet to easterly face of chain link fence post

North 25° East 100.20 feet to found PK nail/shiner in easterly face of utility pole

West 33.05 feet to found capped iron pipe (No. 6193)

2652.68 feet to C-5 (as remonumented) & 2634.12 feet to C-7 (as remonumented)

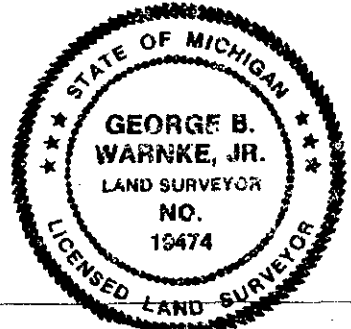

Signed by [Signature] Date 12/17/1996

Surveyor's Michigan License No. 19474

DOCUMENTATION

NOV 02 2000

SECTION

continued from section A

April 1979, G.B. Warnke (LCRC, L.2, P.454) notes "found railroad spike" & witnesses:

S50°W 50.53' nail in E'ly face 12" apple tree &

N25°E 100.2' nail in east face elec. pole & S60°E 50.25' NW face 6" cedar post

November 1984, Case & Fleck (File No. 21333) notes "found R.R. spike" & witnesses:

N75°E 53.57' nail in ??? & S20°E 88.23' nail in P. pole & N28°E 100.20' nail in P. pole;

11/4/93, G.B. Warnke (field notes) show set 1 1/2" capped (#19474) I. Pipe to replace found R.R. spike over bolt;