

APR 28 1995

RATIFIED BY PEER GROUP
PA 345 OF 1970
MONROE COUNTY, MICHIGAN

COMMISSION

Date: 10/26/1993

LAND CORNER RECORDATION CERTIFICATE
Filing Requirement of Act 74, Mich. P.A. 1970

County: MONROE
For corners in: Bedford

MONROE
(County)

Located In: BEDFORD Corner Code: ##
TWP. T 8 S R 7 E

- 1. Public Land Survey C-8
T 8 S R 7 E
T _____ R _____
T _____ R _____
T _____ R _____
- 2. Property Controlling in Section S _____ T _____ R _____
S _____ T _____ R _____
- 3. Miscellaneous Property in Sec. S _____ T _____ R _____
S _____ T _____ R _____

Register of Deeds Stamp & File Number

- 4. Lot No. _____, Recorded Plat _____
- 5. Private Claims _____

MONROE COUNTY REMONUMENTATION PROGRAM Peer Group
approved corner on 10-26-1993 per Act 345 of 1990.

I, G.B. WARNKE, JR., in a field survey on December 2, 19 94
do hereby certify that under requirements of P.A. 74, Michigan P.A. of 1970, the corner points mentioned in lines 1 and 2 above were in conformance with regulations and rules therefore as required in the current manual of survey instructions of the United States Department of the Interior, Bureau of Land Management or by a decree of a Court of Law and/or that the corner points mentioned in lines 3, 4 and 5 above were in conformance with the rules of the Michigan Board of Land Surveyors or by a Decree of a Court of Law, established, re-established, monumented, re-monumented, recovered, found as expressed below:

NOTE: Not more than 4 corners, all in the same town and range, may be recorded on this certificate.

	A	B	C	D	E	F	G	H	I	J	K	L
2	6		5		4		3		2			
3												
4	7		8		9		10		11		12	
5												
6	18		17		16		15		14		13	
7												
8	19		20		21		22		23		24	
9												
10	30		29		28		27		26		25	
11												
12	31		32		33		34		35		36	
13												

A. Description of original monument and accessories and/or subsequent restoration:

C-8, T8S, R7E, 1/4 Corner Common to Sections 19 & 20
G.L.O. Surveyor Joseph Wampler set 1/4 post between Sections 19 & 20. Witnesses: W. Oak 14 inch S.13°E. 27 links & B. Oak 17 inch S.80°W 11 links. / M.C.R.C. survey notes of Consear Road, dated 11/25/25, show iron pipe as intersection point at Secor Road & Consear Road. / On March of 1975, G.B. Warnke found 1/2 inch iron pipe in concrete filled tile and recorded in L.C.R.C., Liber 2, Page 136. / O.A. Case on July 1946, survey notes iron pipe. / L.C.R.C., Liber 3, Page 60, by G.B. Warnke recorded to railroad spike over iron pipe. / Various surveys note railroad spike, P.K. nail, etc., which were probably set over iron pipe in tile, which is accepted as best available evidence of position of the original corner.

B. Description of corner evidence found and/or method applied in restoring or reestablishing corner:

C-8 - 10/25/1993, Found 1 1/4 inch iron pipe at surface and witnessed below.


12/2/1994, set 1 inch x 36 inch iron pipe with brass remonumentation cap inside monument box to replace found pipe.

RECEIVED FOR RECORD
DEC 16 PM 3:32
REG. OF DEEDS
MONROE COUNTY, MICH.
Gene Warnke

C. Description of monument for corner and accessories established to perpetuate locating the position of the corner:

C-8 - Found 1 1/4 inch iron pipe at surface and is accepted as a careful and faithful perpetuation of the position of the original corner and witnesses:
North 30° West 59.67' nail/shiner in east face of telephone pole
North 45° East 44.12' nail/shiner in W. face of utility pole
South 45° East 89.60' northeast corner of frame siding of building No. 8504
South 45° West 48.60' southeast corner of 7 inch x 9 inch wood sign post for "Snyder's"
12/2/1994, set 1 inch x 36 inch iron pipe with brass remonumentation cap inside monument box to replace found pipe.

Signed by [Signature]
Surveyor's Michigan License No. 19474

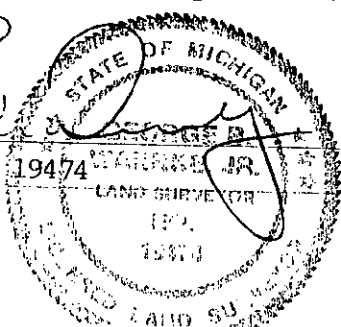

Date December 2, 1994

FORM APPROVED BY MICHIGAN STATE BOARD OF LAND SURVEYORS, JAN. 28, 1971
REVISED MAY 14, 1975
REVISED JAN., 1982