

# SURVEY & REMONUMENTATION COMMISSION

APR 28 1995

RATIFIED BY PEER GROUP  
PA 345 OF 1990  
MONROE COUNTY, MICHIGAN

date: 10-26-1993

County Rep: [Signature]

## COMMISSION

**LAND CORNER RECORDATION CERTIFICATE**  
Filing Requirement of Act 74, Mich. P.A. 1970

RECEIVED FOR RECORD

94 DEC -7 PM 3:24

For corners in

MONROE  
(County)

Located In: BEDFORD Corner Code ##  
TWP.

1. Public Land Survey	T <u>8</u> S <u>R</u> <u>7</u> E	C-11
	T _____ R _____	_____
	T _____ R _____	_____
	T _____ R _____	_____
2. Property Controlling in Section	S _____ T _____ R _____	_____
	S _____ T _____ R _____	_____
3. Miscellaneous Property in Sec.	S _____ T _____ R _____	_____
	S _____ T _____ R _____	_____


*[Signature]*  
REGISTER OF DEEDS  
MONROE COUNTY, MICH

Register of Deeds Stamp & File Number

4. Lot No. \_\_\_\_\_, Recorded Plat \_\_\_\_\_  
5. Private Claims \_\_\_\_\_

MONROE COUNTY REMONUMENTATION PROGRAM Peer Group  
approved corner on 10-26-1993 per Act 345 of 1990.

I, G.B. WARNKE, JR., in a field survey on DECEMBER 2, 1994, do hereby certify that under requirements of P.A. 74, Michigan P.A. of 1970, the corner points mentioned in lines 1 and 2 above were in conformance with regulations and rules therefore as required in the current manual of survey instructions of the United States Department of the Interior, Bureau of Land Management or by a decree of a Court of Law and/or that the corner points mentioned in lines 3, 4 and 5 above were in conformance with the rules of the Michigan Board of Land Surveyors or by a Decree of a Court of Law; established, re-established, monumented, re-monumented, recovered, found as expressed below:

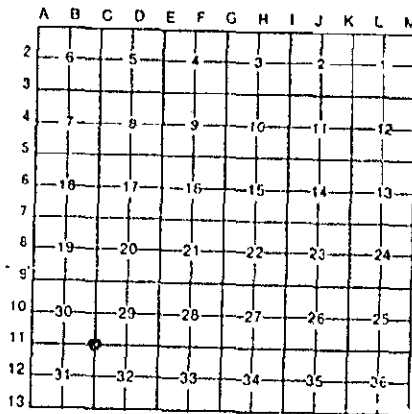

**NOTE: Not more than 4 corners, all in the same town and range, may be recorded on this certificate.**

**A. Description of original monument and accessories and/or subsequent restoration:**

C-11, T8S, R7E, Corner Common to Sections 29, 30, 31 & 32 (At Secor & Sterns Road)  
G.L.O. Surveyor set post at corner of Sections 29, 30, 31 & 32. Witnesses: W. Oak 38 inch S. 40°W. 8 links & Elm 11 inch N49°E. 42 links. / H.R. Fleck witness card notes old stone, no date. / A.J. Marino field notes in April of 1949 note concrete monument. / A.J. Marino field notes in November of 1960 note found iron. / L.C.R.C., Liber 3, Page 136, by Dennis Griggs, dated August of 1990, notes found pipe in concrete. / Various surveys witnessed to P.K. nail. / G.B. Warnke set P.K. nail over pinch pipe in tile set in concrete pavement.

**B. Description of corner evidence found and/or method applied in restoring or reestablishing corner:**

C-11 - 10/26/1993, Found P.K. Nail, referenced, excavated area, and found 4 inch tile approximately 3 inches deep. Set 1" x 30" iron pipe inside tile and witnessed below.

12/2/1994, set 1 inch x 36 inch iron pipe with brass remonumentation cap inside monument box to replace 1 inch x 30 inch iron pipe inside tile.

~~Set witness S40°E 162.56 (162.6 Br) Nuc cor brick school~~  
witness not correct all

**C. Description of monument for corner and accessories established to perpetuate locating the position of the corner:**

C-11 - Set 1" x 30" iron pipe inside tile. Point is accepted as the best available evidence of the position of the original corner and witnesses:

N45°E 43.47' found nail/shiner in southwest face of traffic signal pole

N55°W 54.08' top nut of hydrant

S45°W 45.19' found nail/shiner in northeast face of utility pole

S31°E 64.63' northeast corner at ground 8" x 8" x 24" concrete post (which is thought to be U.S.G.S. post with missing brass plate)

12/2/1994, set 1 inch x 36 inch iron pipe with brass remonumentation cap inside monument box to replace 1 inch x 30 inch iron pipe inside tile.

Signed by [Signature]

Date 12/2/1994

Surveyor's Michigan License No. 19474

