

**SURVEY &
REMONUMENTATION**

APR 28 1995

COMMISSION

LAND CORNER RECORDATION CERTIFICATE
Filing Requirement of Act 74, Mich. P.A. 1970

RECEIVED FOR RECORD

94 DEC 29 AM 11:05

RATIFIED BY PEER GROUP
PA 345 OF 1990
MONROE COUNTY, MICHIGAN

date: 10/26/1993

County Rep.: [Signature]

For corners in

MONROE (County)	Located In: BEDFORD TWP.	Corner Code #
1. Public Land Survey	T 8 S R 7 E	D-3
	T _____ R _____	_____
	T _____ R _____	_____
	T _____ R _____	_____
2. Property Controlling in Section	S _____ T _____ R _____	_____
	S _____ T _____ R _____	_____
3. Miscellaneous Property in Sec.	S _____ T _____ R _____	_____
	S _____ T _____ R _____	_____

[Signature]
REGISTER OF DEEDS
MONROE COUNTY, MICH


Register of Deeds Stamp & File Number

4. Lot No. _____, Recorded Plat _____

5. Private Claims
MONROE COUNTY REMONUMENTATION PROGRAM Peer Group
approved corner on 10-26-1993 per Act 345 of 1990.

1. G.B. WARNKE, JR. in a field survey on 12/19, 19 94
do hereby certify that under requirements of P.A. 74, Michigan P.A. of 1970, the corner points mentioned in lines 1 and 2 above were in conformance with regulations and rules therefore as required in the current manual of survey instructions of the United States Department of the Interior, Bureau of Land Management or by a decree of a Court of Law and/or that the corner points mentioned in lines 3, 4 and 5 above were in conformance with the rules of the Michigan Board of Land Surveyors or by a Decree of a Court of Law; established, re-established, monumented, re-monumented, recovered, found as expressed below:

NOTE: Not more than 4 corners, all in the same town and range, may be recorded on this certificate.

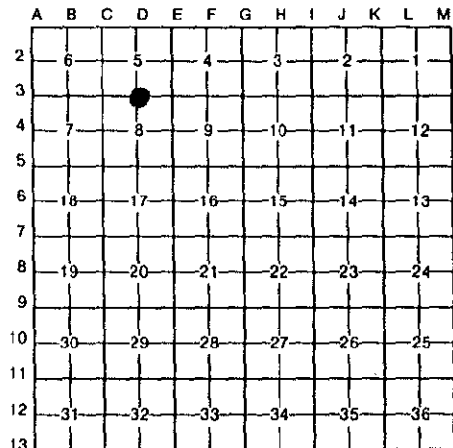


A. Description of original monument and accessories and/or subsequent restoration:

D-3, T8S, R7E, 1/4 Corner Between Sections 5 & 8 (On County Road 151)
G.L.O. Surveyor Joseph Wampler set 1/4 section post at 41.0 chains west from section corner. Witnesses: W. Oak 19 inch S.63 1/2 E. 357 links & no other bearing tree. / Old notes not found. / State highway survey by L.J. Czubak in March of 1964 stated 3 witnesses to an ackerman bolt. After repaving, M.S.H.D. Survey Chief K.M. Liubakka set a boat spike in monument box and rewitnessed 10/11/65. / L.E. Moree in December of 1974 recorded L.C.R.C., Liber 1, Page 470, to iron pin in monument box. / All surveys to date use iron pin in monument box.

B. Description of corner evidence found and/or method applied in restoring or reestablishing corner:

D-3 On, 10/22/1993 - Found 1 inch round top iron rod in concrete in broken top monument box (approximately 0.2 feet south of the centerline of Samaria Road pavement) and witnessed as shown below; 12/19/1994, set plastic remonumentation cap on found rod.

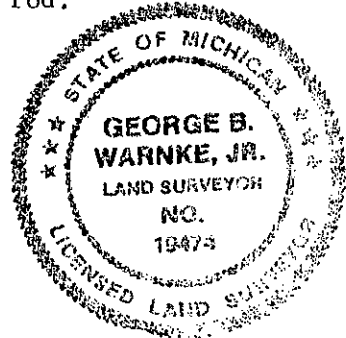

C. Description of monument for corner and accessories established to perpetuate locating the position of the corner:

D-3 - Found 1 inch round top iron rod in concrete in broken top monument box (approximately 0.2 feet south of the centerline of Samaria Road pavement.) and is accepted as the best available evidence of the position of the original corner and witnesses:
North 10° East 35.09' nail/shiner in east face of telephone pole
North 33.04' capped (No. 19474) iron pipe (metal "T" fence post 0.3 feet southeast of iron)
South 25° East 36.44' nail/shiner in north face of utility pole (No. 472)
North 40° West 31.39' south intersection of "I" beam used as east post of metal guard rail on north side of road
South 75° West 105.44' north intersection of "I" beam used as east post of metal guard rail on south side of road
South 50° West 20.48' found "+" in 294+00 stamped in concrete pavement (south edge)

Signed by [Signature] Date 12/19/1994
Surveyor's Michigan License No. 19474