

# SURVEY & REMONUMENTATION

APR 28 1995

COMMISSION

## LAND CORNER RECORDATION CERTIFICATE Filing Requirement of Act 74, Mich. P.A. 1970

RECEIVED FOR RECORD

94 DEC -9 PM 1:00

*Leri Allen*  
REGISTER OF DEEDS  
MONROE COUNTY, MICH

MONROE COUNTY, MICHIGAN

date 11-16-93  
County Rep: [Signature]

For corners in  
MONROE  
(County)

Located In: BEDFORD Corner Code 77  
TWP.

1. Public Land Survey	T <u>8</u> S R <u>7</u> E	<u>D-5</u>
	T _____ R _____	_____
	T _____ R _____	_____
	T _____ R _____	_____
2. Property Controlling in Section	S _____ T _____ R _____	_____
	S _____ T _____ R _____	_____
3. Miscellaneous Property in Sec.	S _____ T _____ R _____	_____
	S _____ T _____ R _____	_____

Register of Deeds Stamp & File Number

4. Lot No. \_\_\_\_\_, Recorded Plat \_\_\_\_\_  
5. Private Claims \_\_\_\_\_

**1993 MONROE COUNTY REMONUMENTATION PROGRAM**

Peer Group approved corner on 11/16/1993 per Act 345 of 1990.

I, G.B. WARNKE, JR., in a field survey on 11/17/1994, 19\_\_\_\_\_, do hereby certify that under requirements of P.A. 74, Michigan P.A. of 1970, the corner points mentioned in lines 1 and 2 above were in conformance with regulations and rules therefore as required in the current manual of survey instructions of the United States Department of the Interior, Bureau of Land Management or by a decree of a Court of Law and/or that the corner points mentioned in lines 3, 4 and 5 above were in conformance with the rules of the Michigan Board of Land Surveyors or by a Decree of a Court of Law; established, re-established, monumented, re-monumented, recovered, found as expressed below:

**NOTE: Not more than 4 corners, all in the same town and range, may be recorded on this certificate.**


	A	B	C	D	E	F	G	H	I	J	K	L	M
2	6	5	4	3	2	1							
3													
4	7	8	9	10	11	12							
5													
6	10	17	16	15	14	13							
7													
8	19	20	21	22	23	24							
9													
10	30	29	28	27	26	25							
11													
12	31	32	33	34	35	36							

A. Description of original monument and accessories and/or subsequent restoration:

**D-5, T8S, R7E, 1/4 Corner Common to Sections 8 & 17**  
(On Erie Road - 1/2 Mile West of Douglas Road)  
1820, G.L.O. Surveyor Joseph Wampler set 1/4 post between Sections 8 & 17. Witnesses: W. Oak 16 (inch) S. 11° E. 136 (links) & B. Oak 18 (inch) S. 61° W 168 (links). / Old witness card, 1945, notes stone. / A.J. Marino used stone in Jan. of 1948 & March of 1953. / About 1975, G.B. Warnke excavated and found R.R. spike over stone 1.6 feet deep and set 2 inch square head iron bolt over stone. / 1972, M.R. Fleck recorded L.C.R.C., L. 1, Pg. 147, to R.R. spike. / Surveyors have used iron bolt over stone with no apparent dispute.

B. Description of corner evidence found and/or method applied in restoring or reestablishing corner:

D-5 - 11/12/1993, found 2 inch square head bolt with cut "+" over stone and witnessed as shown below.  
11/17/1994, set 1 inch x 36 inch iron pipe with brass remonumentation cap inside monument box to replace bolt over stone.

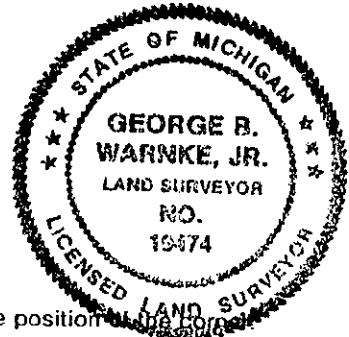

C. Description of monument for corner and accessories established to perpetuate locating the position of the corner:

D-5 - Set 1 inch x 36 inch iron pipe with brass remonumentation cap inside monument box to replace found 2 inch square head bolt with cut "+" over stone & is accepted as the best available evidence of the position of the original corner & witnesses:  
South 05° West 31.01' found nail/shiner in north face of utility pole  
North 50° East 52.54' east end of 12 inch concrete culvert  
South 30° East 110.45' set nail/shiner in north face of utility pole  
North +/- 2.5' center of asphalt pavement  
North 30° West 44.10' set nail/shiner in southwest face of 8 inch White Pine (nail +/- 3' above ground)

Signed by [Signature]  
Surveyor's Michigan License No. 19474

Date 11/17/1994