

MAY 20 1997

LAND CORNER RECORDATION CERTIFICATE RECEIVED FOR RECORD
 Filing Requirement of Act 74, Mich. P.A. 1970

96 NOV 22 PM 2:37

COMMISSION

For corners in
MONROE (58)
 (County)

Located In:	Corner Code #
1. Public Land Survey	T _____ R _____
	T _____ R _____
<u>BEDFORD TWP.</u>	T <u>8S</u> R <u>7E</u> <u>E-5</u>
	T _____ R _____
2. Property Controlling in Section	S _____ T _____ R _____
	S _____ T _____ R _____
3. Miscellaneous Property in Sec.	S _____ T _____ R _____
	S _____ T _____ R _____

Kari Allen
 REGISTER OF DEEDS
 MONROE COUNTY, MICH


Register of Deeds Stamp & File Number

4. Lot No. _____, Recorded Plat _____
 5. Private Claims _____

1996 REMONUMENTATION PROGRAM CORNER

I, G. B. WARNKE, JR., in a field survey on 1996, 19 _____, do hereby certify that under requirements of P.A. 74, Michigan P.A. of 1970, the corner points mentioned in lines 1 and 2 above were in conformance with regulations and rules therefore as required in the current manual of survey instructions of the United States Department of the Interior, Bureau of Land Management or by a decree of a Court of Law and/or that the corner points mentioned in lines 3, 4 and 5 above were in conformance with the rules of the Michigan Board of Land Surveyors or by a Decree of a Court of Law, established, re-established, monumented, re-monumented, recovered, found as expressed below:

NOTE: Not more than 4 corners, all in the same town and range, may be recorded on this certificate.

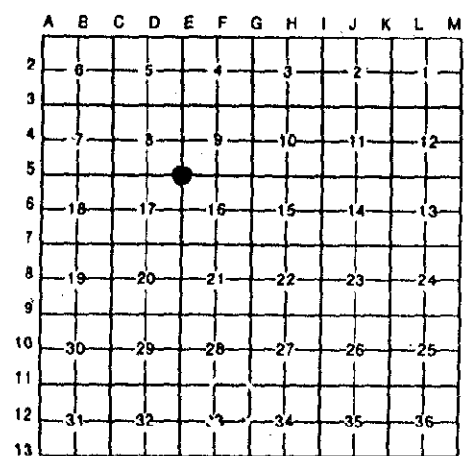

A. Description of original monument and accessories and/or subsequent restoration:

Corner Common To Sections 8, 9, 16 & 17 at Douglas Road & Erie Road in paved surface.
 In 1820, G.L.O. Surveyor, Joseph Wampler set post corner of Sections 8, 9, 16 & 17 & witnesses: W. Oak 20 inch N.50°E. 126 links & B. Oak 16 inch N.16°E. 87 links.
 Old book indicates stone (Book 12, Page 41), Surveyor unknown.
 J.W. White survey, 8/22/28, shows pipe.
 Surveys in the late 1940's and the 1950's have vague descriptions of corner.
 Case & Fleck notes iron pipe in August of 1951 and a 1/2 inch iron pipe in 1953.
 A.J. Marino in June of 1943 notes old iron pipe over stone.
 Section A continued on back side

B. Description of corner evidence found and/or method applied in restoring or reestablishing corner:


9/13/1993, found nail set over found 2 inch square head bolt & witnessed as shown below.
 1996, found nail & washer & checked 1993 witnesses. 6/11/96, corner approved at Peer Group Remon. Meeting.
 10/2/96, Warnke crew checked witnesses & found a 2' O/S's nail/shiner at surface of road.
 2" square railroad bolt found underneath asphalt surface. Underneath RR bolt, found a 1.5" iron pipe (bottom of pipe at 3.3' depth). Beside RR bolt, found bent rod going to the southwest towards RR bolt. Dug 3' down and pulled out 3/4" x 1.70' iron rod inside a 1" ID x 2.40' pipe (bottom of pipe at 3' depth), which was from the 2' witness points measured at 1.70 north and 1.83 East. Set 1" x 36" iron pipe inside monument box to replace found railroad bolt & witnessed below. 10/1/96 - set brass remon. cap on previously set 1" pipe.
 10/4/96, (Secondary Point) Warnke crew found PK nail (2" long" at the surface in Erie Road - AZ 239°-46' 10.08' (assume AZ 270° down Erie Road to west) from 1" iron pipe in monument box. Dug 12" x 12" hole around PK nail and found 1" OD x 15" iron pipe being 11 1/2 inches below asphalt surface and removed to excavate to a depth of 18 inches and probed in all directions with no further evidence found. Refilled hole and reset iron pipe at surface / cut off top 3 inches as pipe split and mangled while trying to reset.

Description of monument for corner and accessories established to perpetuate locating the position of the corner:

Set 1" x 36" iron pipe with brass remonumentation cap in monument box to replace found nail set over found 2 inch square head railroad bolt over iron pipe and is accepted as the best available evidence of the position of the original corner and witnesses:
 with 35° East 38.1 feet to chisled "v" in north rim of sanitary manhole
 with 45° East 44.37 feet to nail/washer in southwest face of guy pole
 with 60° West 62.67 feet to chisled "+" in top of north end of 36 inch concrete culvert
 with 45° West 45.14 feet to nail/coin in east face of utility pole
 with 40° East 111.45 feet to southwest corner of residence No. 2486
 with 60° West 10.08 feet to found 1" OD iron pipe (Secondary Point)

RATIFIED BY PEER GROUP
 PA 345 OF
 MONROE COUNTY, MICHIGAN
 date: 6/11/1996
 County Rep.: [Signature]

Recorded by [Signature]
 Surveyor's Michigan License No. 19474

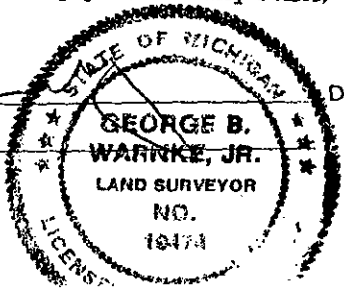

Date 10/16/1996

REMONUMENTATION PROGRAM CORNER

Section A continued from front side

Various surveys vary between iron bolt (G.B. Warnke) over iron pin found at centerline intersection on line and equal distance to 1/8 corner stone and 1/4 corner stone to west. G.B. Warnke, Job File #78-57, found iron pin and set square head bolt over pin, and L.C.R.C., Liber 2, Page 218, states iron bolt over iron pin and L.C.R.C., Liber 3, Page 294, states set 2 inch concrete nail and washer over 1 3/4 inch square head bolt 2 inches deep over iron pin.

SURVEY &
REMONUMENTATION

MAY 20 1997

COMMISSION