

# SURVEY & REMONUMENTATION

APR 28 1995

COMMISSION

RATIFIED BY PEER GROUP  
PA 345 OF 1990  
MONROE COUNTY, MICHIGAN  
Date: 9/6/1994  
County Rep.: [Signature]

RECEIVED FOR RECORD  
94 DEC 29 AM 11:07

## LAND CORNER RECORDATION CERTIFICATE Filing Requirement of Act 74, Mich. P.A. 1970

*[Signature]*  
REGISTER OF DEEDS  
MONROE COUNTY, MICH

or corners in  MONROE <small>(County)</small>  Public Land Survey    Property Controlling in Section Miscellaneous Property in Sec.	Located In: Bedford Twp.  T <u>8</u> S <u>R</u> 7 E T _____ R _____ T _____ R _____ T _____ R _____ S _____ T _____ R _____ S _____ T _____ R _____ S _____ T _____ R _____ S _____ T _____ R _____	Corner Code #  E-8 _____ _____ _____ _____ _____ _____ _____
---	---	---

Register of Deeds Stamp & File Number

Lot No. \_\_\_\_\_, Recorded Plat \_\_\_\_\_  
Private Claims \_\_\_\_\_

**1994 MONROE COUNTY REMONUMENTATION PROGRAM**  
Peer Group approved corner on 9/6/1994 per Act 345 of 1990.

G.B. WARNKE, JR. in a field survey on 12/14/1994, 19\_\_\_\_\_.  
I hereby certify that under requirements of P.A. 74, Michigan P.A. of 1970, the corner points mentioned in lines 1 and 2 above were in conformance with regulations and rules therefore as required in the current manual of survey instructions of the United States Department of the Interior, Bureau of Land Management or by a decree of a Court of Law and/or that the corner points mentioned in lines 3, 4 and 5 above were in conformance with the rules of the Michigan Board of Land Surveyors or by a Decree of a Court of Law; established, re-established, monumented, re-monumented, recovered, found as expressed below:

**NOTE: Not more than 4 corners, all in the same town and range, may be recorded on this certificate.**

	A	B	C	D	E	F	G	H	I	J	K	L	M
2	6	5	4	3	2	1							
3													
4	7	8	9	10	11	12							
5													
6	18	17	16	15	14	13							
7													
8	19	20	21	22	23	24							
9													
10	30	29	28	27	26	25							
11													
12	31	32	33	34	35	36							
13													

Description of original monument and accessories and/or subsequent restoration:


E-8, T8S, R7E, 1/4 Corner Common to Sections 20 & 21 (At Consear & Douglas Roads)  
1820, G.L.O. Surveyor, Joseph Wampler, set 1/4 corner post between Sections 20 & 21; witnesses: W. Oak 44 (inch) S.66°E. 13 links & W. Oak 46 (inch) S.67°W. 34 links. 1911, J.W. White notes stone. 1942, stone found. 1944, A.J. Marino notes found red granite stone. 1952, Case & Fleck survey shows iron pin. 1972, M.R. Fleck survey states set railroad spike, according to 1950 survey. 1973 & 1977, G.B. Warnke used railroad spike. 1992, James VanHavermaat and G.B. Warnke used railroad spike.

Description of corner evidence found and/or method applied in restoring or reestablishing corner:

E-8 - 10/29/1993, Found railroad spike. On 11/16/1993, excavated under found railroad spike and found stone 0.6 feet north of spike. 12/14/1994, set 1 inch x 36 inch iron pipe with brass remonumentation cap inside monument box over stone to replace railroad spike.

Description of monument for corner and accessories established to perpetuate locating the position of the corner:

E-8 - Set 1 inch x 36 inch iron pipe with brass remonumentation cap inside monument box over stone to replace railroad spike and is accepted as the best available evidence of the position of the original corner and witnesses:  
 South 30° West 69.25 feet to top nut of hydrant  
 South 70° West 90.23 feet to set nail/shiner in north face of telephone pole  
 North 30° West 71.97 feet to found nail/shiner in northeast face of utility pole  
 North 30° East 74.09 feet to found nail/shiner in northwest face of guy pole  
 South 35° East 42.23 feet to set nail/shiner in west face of telephone pole

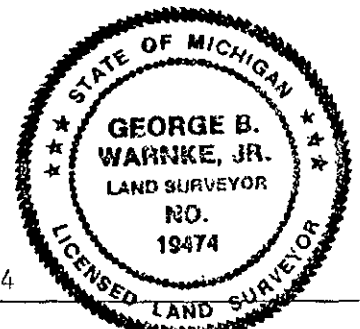

Set by [Signature] Date 12/14/1994  
Surveyor's Michigan License No. 19474