

**SURVEY &
REMONUMENTATION**

DEC 07 1994

RECEIVED FOR RECORD
94 OCT 12 PM 2:17

RATIFIED BY PEER GROUP
FA 345 OF 1990
MONROE COUNTY, MICHIGAN

date: 11-08-93
County Rep.: [Signature]

**COMMISSION
LAND CORNER RECORDATION CERTIFICATE
Filing Requirement of Act 74, Mich. P.A. 1970**

For corners in

<u>MONROE</u> (County)	Located In:	Corner Code #
	BEDFORD TWP.	
1. Public Land Survey	T <u>8</u> S R <u>7</u> E	<u>G-11</u>
	T _____ R _____	_____
	T _____ R _____	_____
	T _____ R _____	_____
2. Property Controlling in Section	S _____ T _____ R _____	_____
	S _____ T _____ R _____	_____
3. Miscellaneous Property in Sec.	S _____ T _____ R _____	_____
	S _____ T _____ R _____	_____

Keri Allen
REGISTER OF DEEDS
MONROE COUNTY, MICH

Register of Deeds Stamp & File Number

4. Lot No. _____, Recorded Plat _____
5. Private Claims _____

MONROE COUNTY REMONUMENTATION PROGRAM Peer Group
approved corner on 11/08/1993 per Act 345 of 1990.

	A	B	C	D	E	F	G	H	I	J	K	L	M
2	6	5	4	3	2	1							
3													
4	7	8	9	10	11	12							
5													
6	18	17	16	15	14	13							
7													
8	19	20	21	22	23	24							
9													
10	30	29	28	27	26	25							
11													
12	31	32	33	34	35	36							
13													

I, G.B. WARNKE, JR., in a field survey on SEPTEMBER 2, 19 94, do hereby certify that under requirements of P.A. 74, Michigan P.A. of 1970, the corner points mentioned in lines 1 and 2 above were in conformance with regulations and rules therefore as required in the current manual of survey instructions of the United States Department of the Interior, Bureau of Land Management or by a decree of a Court of Law and/or that the corner points mentioned in lines 3, 4 and 5 above were in conformance with the rules of the Michigan Board of Land Surveyors or by a Decree of a Court of Law; established, re-established, monumented, re-monumented, recovered, found as expressed below:


NOTE: Not more than 4 corners, all in the same town and range, may be recorded on this certificate.

A. Description of original monument and accessories and/or subsequent restoration:
G-11, T8S, R7E, Section Corner Common to Sections 27, 28, 33 & 34
(Intersection of Jackman Road & Sterns Road)
G.L.O. Surveyor, Joseph Wampler set post for Sections 27, 28, 33 & 34. / L.A. Howard in 1903 used stone. Witnesses to church okay. / Various surveys used valve or railroad spike in 1960's & 1970's. / September of 1975, G.B. Warnke dug and found pieces of red granite stone and set 3/4 inch by 10 inch iron pipe by stones.

B. Description of corner evidence found and/or method applied in restoring or reestablishing corner:
G-11 - On 11/03/93, found 1 inch hex top by 2 inch bolt at surface, 3 inches deep under bolt found 3/4 inch x 10 inch iron pipe with remains of a cap, found broken granite stone around pipe (stone had been approximately 9 inches by 12 inches by 8 inches - now 2 larger and 5 smaller pieces), removed stone and dug 17 inches deeper and probed approximately 2 feet but found nothing more. Set 1 foot square top monument box by 15 inches and 1 inch by 36 inch iron pipe inside box at location of bolt and pipe and placed remains of stone around pipe. 9/2/1994, set brass remonumentation cap on 1 inch x 36 inch iron pipe.

C. Description of monument for corner and accessories established to perpetuate locating the position of the corner:
G-11 - Set Square Top Monument Box & 1 Inch x 36 Inch Iron Pipe Inside Box & Remains Of Stone Around Pipe and is accepted as the best available evidence of the position of the original corner and 9/2/94, brass remon. cap set on iron pipe and witnesses:
North 45° East 42.59' found nail/bottle cap in southeast face of utility pole
North 45° East 42.20' found nail & F.P. & S. tag in southwest face of utility pole
North 40° West 105.95' southeast corner of foundation of old St. Luke's Lutheran Church
South 45° East 45.23' found nail & F.P. & S. tag in northwest face of utility pole
South 45° East 46.26' found nail/bottle cap in northeast face of utility pole
South 30° West 43.97' top nut of hydrant
South 50° West 41.73' found nail & F.P. & S. tag in northeast face of telephone traffic signal support pole
(2 concrete nails/shiners are at 3.0 feet north & 3.0 feet west of pipe)

signed by [Signature] Date 9/27/94
Surveyor's Michigan License No. 19474

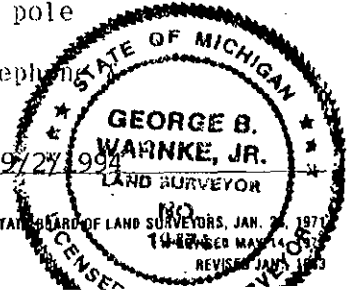

FORM APPROVED BY MICHIGAN STATE BOARD OF LAND SURVEYORS, JAN. 24, 1971
REVISED MAY 14, 1993