

SURVEY & REMONUMENTATION

RATIFIED BY PEER GROUP
PA 345 OF 1990
MONROE COUNTY, MICHIGAN

APR 28 1995

date: 10/19/1993

County Rep.: [Signature]

COMMISSION LAND CORNER RECORDATION CERTIFICATE Filing Requirement of Act 74, Mich. P.A. 1970

For corners in

MONROE

(County)

Located In: BEDFORD Corner Code ##
TWP.

1. Public Land Survey	T <u>8</u> S R <u>7</u> E	<u>H-5</u>
	T _____ R _____	_____
	T _____ R _____	_____
	T _____ R _____	_____
2. Property Controlling in Section	S _____ T _____ R _____	_____
	S _____ T _____ R _____	_____
3. Miscellaneous Property in Sec.	S _____ T _____ R _____	_____
	S _____ T _____ R _____	_____

Register of Deeds Stamp & File Number

4. Lot No. _____, Recorded Plat _____
5. Private Claims _____

MONROE COUNTY REMONUMENTATION PROGRAM Peer Group
approved corner on 10/26/1993 per Act 345 of 1990.

I, G.B. WARNKE, JR., in a field survey on November, 1994, do hereby certify that under requirements of P.A. 74, Michigan P.A. of 1970, the corner points mentioned in lines 1 and 2 above were in conformance with regulations and rules therefore as required in the current manual of survey instructions of the United States Department of the Interior, Bureau of Land Management or by a decree of a Court of Law and/or that the corner points mentioned in lines 3, 4 and 5 above were in conformance with the rules of the Michigan Board of Land Surveyors or by a Decree of a Court of Law; established, re-established, monumented, re-monumented, recovered, found as expressed below:

NOTE: Not more than 4 corners, all in the same town and range, may be recorded on this certificate.

A	B	C	D	E	F	G	H	I	J	K	L
2	6	5	4	3	2						
3											
4	7	8	9	10	11						
5				15	14						
6	18	17	16	15	14						
7											
8	19	20	21	22	23	24					
9											
10	30	29	28	27	26	25					
11											
12	31	32	33	34	35	36					
13											


A. Description of original monument and accessories and/or subsequent restoration:
H-5, T8S, R7E, 1/4 Corner Between Sections 10 & 15
(On Erie Road - 1/2 Mile East of Jackman Road)

G.L.O. Surveyor Joseph Wampler set 1/4 section post between Sections 10 & 15. Witnesses: W. Oak 20 inch N.82°E. 48 links & W. Oak 16 inch N.44°W. 23 links. / August of 1972, M.R. Fleck, Survey No. 16500, (Liber 636, Page 173), and L.C.R.C., L. 1, Pg. 175, notes found stone & iron. / A.J. Marino in 1972 found stone & iron. / 9-14-93, found "T" iron at surface, referenced, dug hole & found stone 18 inches deep with 1/2 inch iron pipe leaning south over north edge of stone & referenced high point of stone, left "T" iron next to stone & set 1 inch by 17 inch iron pipe over stone to replace found "T" iron over stone.

B. Description of corner evidence found and/or method applied in restoring or reestablishing corner:

H-5 - 9/14/1993, set 1 inch x 17 inch iron pipe over stone to replace found "T" iron which was over stone (as stated above) and witnessed as shown below.

11/1994, set 1 inch x 36 inch iron pipe with brass remonumentation cap inside monument box to replace pipe over stone.

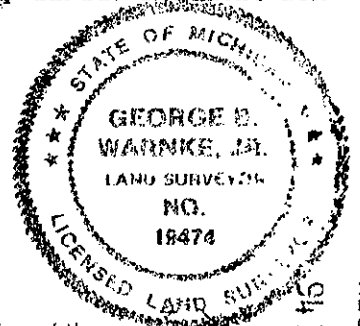

C. Description of monument for corner and accessories established to perpetuate locating the position of the corner:

H-5 - Set 1 inch by 17 Inch Iron Pipe Over Stone and is accepted as the best available evidence of the position of the original corner and witnesses:

- South 157.50' northwest corner of house No. 1361
- South 15° East 37.00' found nail/shiner in east face of utility pole
- South 25° East 39.71' found nail/shiner in northeast face of 24 inch Chinese Elm
- South 15° West 154.92' northeast corner of house No. 1388
- South 5° West 25.00' found nail/washer in north face of 24 inch Maple

11/1994, set 1 inch x 36 inch iron pipe with brass remonumentation cap inside monument box to replace pipe over stone.

Signed by [Signature] Date November 28, 1994

Surveyor's Michigan License No. 19474

RECEIVED FOR RECORD
94 DEC 16 PM 3:39