

SURVEY & REMONUMENTATION

APR 28 1995

RATIFIED BY PEER GROUP
PA 345 OF 1990
MONROE COUNTY, MICHIGAN

date: 11/8/1993
County Rep.: [Signature]

COMMISSION
LAND CORNER RECORDATION CERTIFICATE
Filing Requirement of Act 74, Mich. P.A. 1970

RECEIVED FOR RECORD

94 DEC 29 AM 11:10

Leri Allen
REGISTER OF DEEDS
MONROE COUNTY, MICH

For corners in
MONROE
(County)

Located In: BEDFORD Corner Code #
TWP.

1. Public Land Survey	T <u>8</u> S <u>R</u> 7 E	I-3	
	T _____ R _____		
	T _____ R _____		
	T _____ R _____		
2. Property Controlling in Section	S _____ T _____ R _____		
	S _____ T _____ R _____		
3. Miscellaneous Property in Sec.	S _____ T _____ R _____		

Register of Deeds Stamp & File Number

4. Lot No. _____, Recorded Plat _____
5. Private Claims _____

MONROE COUNTY REMONUMENTATION PROGRAM Peer Group
approved corner on 11/08/1993 per Act 345 of 1990.

I, G.B. WARNKE, JR., in a field survey on 12/16, 19 94, do hereby certify that under requirements of P.A. 74, Michigan P.A. of 1970, the corner points mentioned in lines 1 and 2 above were in conformance with regulations and rules therefore as required in the current manual of survey instructions of the United States Department of the Interior, Bureau of Land Management or by a decree of a Court of Law and/or that the corner points mentioned in lines 3, 4 and 5 above were in conformance with the rules of the Michigan Board of Land Surveyors or by a Decree of a Court of Law, established, re-established, monumented, re-monumented, recovered, found as expressed below:

	A	B	C	D	E	F	G	H	I	J	K	L	M
2	6	5	4	3	2	1							
3									●				
4	7	8	9	10	11	12							
5													
6	18	17	16	15	14	13							
7													
8	19	20	21	22	23	24							
9													
10	30	29	28	27	26	25							
11													
12	31	32	33	34	35	36							
13													

NOTE: Not more than 4 corners, all in the same town and range, may be recorded on this certificate.

A. Description of original monument and accessories and/or subsequent restoration:

T-3, T8S, R7E, Section Corner Common to Sections 2, 3, 10 & 11
(At Lewis Avenue & Samaria Road [M-151])

1820, G.L.O. Surveyor set post. Witnesses: B. Oak 16 inch S.36°E. 30 links & B. Oak 14 inch N.36°W. 57 links. / M.S.H.D. set ackerman bolt in March of 1964. / M.R. Fleck surveys in February of 1973, July of 1973, March of 1974, and August of 1978 indicate a monument box in place. / G.B. Warnke in July of 1985 set a PK nail & washer over a found iron pin in monument box under asphalt pavement. G.B. Warnke found point in February of 1993 and recorded same in L.C.R.C., Liber 3, Page 190.

B. Description of corner evidence found and/or method applied in restoring or reestablishing corner:

T-3 On 10/26/1993, found PK nail & washer with very strong metallic reading around it (possibly a monument box). Found another PK nail approximately 2.2' west & 0.7' north (2.34' as direct measurement). 11/16/1993 - Found PK nail at surface & found boat spike under PK nail 2 inches below surface (possibly in monument box). Set 1 Inch x 3 Inch Pipe (Pipe would not drive deeper) around Boat Spike (Removed Found PK Nail & Washer).


12/16/1994, set 1 1/2 inch ring on existing monument box and set plastic remonumentation cap on boat spike (previously set 1 inch x 3 inch iron pipe came off boat spike). (Strong metallic reading was the existing monument box.)

C. Description of monument for corner and accessories established to perpetuate locating the position of the corner:

Set 1 1/2 inch ring on existing monument box and set plastic remonumentation cap around Boat Spike (with very strong metallic reading) (Removed Found PK Nail & Washer) and is accepted as the best available evidence of the position of the original corner and witnesses:

South 45° West 49.30' found nail/shiner in southeast face of utility pole
South 45° East 44.82' found nail/washer in northwest of guy pole
South 70° West 121.3' northwest corner of building foundation
North 50° East 95.50' southwest corner of "party store" foundation

Signed by [Signature] Date 12/16/1994
Surveyor's Michigan License No. 19474

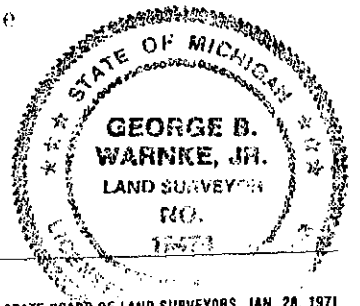

FORM APPROVED BY MICHIGAN STATE BOARD OF LAND SURVEYORS, JAN. 28, 1971
REVISED MAY 14, 1975
REVISED JAN., 1983