

SURVEY & REMONUMENTATION

APR 28 1995

RATIFIED BY PEER GROUP
PA 345 OF 1990
MONROE COUNTY, MICHIGAN

COMMISSION LAND CORNER RECORDATION CERTIFICATE Filing Requirement of Act 74, Mich. P.A. 1970

RECEIVED FOR RECORD
94 DEC 29 AM 10:57

date: 8/23/1994
County Rep.: [Signature]

Eric Allen
REGISTER OF DEEDS
MONROE COUNTY, MICH

For corners in

MONROE <small>(County)</small>	Located In: BEDFORD TWP.	Corner Code #:
1. Public Land Survey	T 8 S R 7 E	I-5
	T _____ R _____	_____
	T _____ R _____	_____
	T _____ R _____	_____
2. Property Controlling in Section	S _____ T _____ R _____	_____
	S _____ T _____ R _____	_____
3. Miscellaneous Property in Sec.	S _____ T _____ R _____	_____
	S _____ T _____ R _____	_____


Register of Deeds Stamp & File Number

4. Lot No. _____, Recorded Plat _____
5. Private Claims _____

1994 MONROE COUNTY REMONUMENTATION PROGRAM

Peer Group approved corner on 8/23/1994 per Act 345 of 1990.

I, G.B. WARNKE, JR., in a field survey on 12/21/1994, 19____, do hereby certify that under requirements of P.A. 74, Michigan P.A. of 1970, the corner points mentioned in lines 1 and 2 above were in conformance with regulations and rules therefore as required in the current manual of survey instructions of the United States Department of the Interior, Bureau of Land Management or by a decree of a Court of Law and/or that the corner points mentioned in lines 3, 4 and 5 above were in conformance with the rules of the Michigan Board of Land Surveyors or by a Decree of a Court of Law; established, re-established, monumented, re-monumented, recovered, found as expressed below:

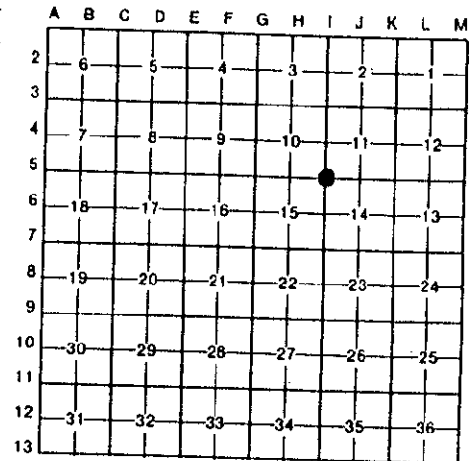

NOTE: Not more than 4 corners, all in the same town and range, may be recorded on this certificate.

A. Description of original monument and accessories and/or subsequent restoration:

I-5, T8S, R7E, Section Corner Common to Sections 10, 11, 14 & 15 (Erie & Jackman Roads - tarby) 1820, G.L.O. Surveyor set post at corner of Sections 10, 11, 14 & 15 and witnessed: W. Oak 28 (inch) N.30°W. 150 links & W. Oak 20 (inch) N.6°E. 16 links. 1971 to 1988, notes P.K. nail by M.R. Fleck, G.B. Warnke, and others. Monroe County Road Commission set a monument box after Lewis Avenue paving project. 1991 to present, G.B. Warnke and others have used monument box. 1992, G.B. Warnke recorded L.C.R.C., Liber 3, Page 236, to stone in monument box.

B. Description of corner evidence found and/or method applied in restoring or reestablishing corner:

I-5 - 8/1994, found stone in monument box and checked witnesses as shown below. 12/21/1994, set 1 inch x 36 inch iron pipe with brass remonumentation cap inside existing monument box to replace stone.

C. Description of monument for corner and accessories established to perpetuate locating the position of the corner:

I-5 - Set 1 inch x 36 inch iron pipe with brass remonumentation cap in existing monument box and is accepted as the best available evidence of the position of the original corner and Witnesses:
South 35° West 46.34 feet to found nail/shiner southeast face utility pole
South 30° East 72.34 feet to chiseled "x" in rim of sanitary manhole
North 50° West 55.53 feet to chiseled "x" in rim of sanitary manhole
North 40° East 43.73 feet to found nail/shiner in southeast face of guy pole

Signed by [Signature] Date 12/21/1994
Surveyor's Michigan License No. 19474

