

**SURVEY &
REMONUMENTATION**

DEC 16 1996

COMMISSION LAND CORNER RECORDATION CERTIFICATE
Filing Requirement of Act 74, Mich. P.A. 1970

For corners in
Monroe (58)
(County)

Located In: _____ Corner Code **##**

1. Public Land Survey	T _____ R _____	_____
Bedford Twp.	T <u>8S</u> R <u>7E</u>	<u>J-2</u>
	T _____ R _____	_____
	T _____ R _____	_____
2. Property Controlling	S _____ T _____ R _____	_____
in Section	S _____ T _____ R _____	_____
3. Miscellaneous	S _____ T _____ R _____	_____
Property in Sec.	S _____ T _____ R _____	_____

RECEIVED FOR RECORD
95 SEP -6 PM 1:46

David Allen
REGISTER OF DEEDS
MONROE COUNTY, MICH.

Register of Deeds Stamp & File Number

4. Lot No. _____, Recorded Plat _____
5. Private Claims _____

GEORGE B. WARNKE, JR. CORNER

I, G.B. WARNKE, JR., in a field survey on 1996, 19 _____, do hereby certify that under requirements of P.A. 74, Michigan P.A. of 1970, the corner points mentioned in lines 1 and 2 above were in conformance with regulations and rules therelore as required in the current manual of survey instructions of the United States Department of the Interior, Bureau of Land Management or by a decree of a Court of Law and/or that the corner points mentioned in lines 3, 4 and 5 above were in conformance with the rules of the Michigan Board of Land Surveyors or by a Decree of a Court of Law; established, re-established, monumented, re-monumented, recovered, found as expressed below:

A	B	C	D	E	F	G	H	I	J	K	L	M
2	6	5	4	3					2			
3												
4	7	8	9	10	11	12						
5												
6	18	17	16	15	14	13						
7												
8	19	20	21	22	23	24						
9												
10	30	29	28	27	26	25						
11												
12	31	32	33	34	35	36						
13												

NOTE: Not more than 4 corners, all in the same town and range, may be recorded on this certificate.

A. Description of original monument and accessories and/or subsequent restoration:

Center ~~corner~~^{OF} to Section 2 / corner in field (1/2 mile off roads)
GLO Surveyors did not set center.
G.B. Warnke: 1989, (survey #86-404) found stone and set 3/4" I. pipe 0.2' west & 0.1' south of high point with old fences to north, south, east, and west and 1991, found stone and pipe and used.
No further information found on corner from other surveyors' files.

B. Description of corner evidence found and/or method applied in restoring or reestablishing corner:

2/1996 - G.B. Warnke crew found stone and pipe and witnessed as shown below.
7/31/96 - G.B. Warnke crew moved granite stone to south and set 1" x 36" iron pipe with brass remonumentation cap to replace stone.


RATIFIED BY PEER GROUP
PA 345 OF 1990
MONROE COUNTY, MICHIGAN
date: 6/11/96
County Rep.: [Signature]

C. Description of monument for corner and accessories established to perpetuate locating the position of the corner:

Set 1" x 36" iron pipe with brass remonumentation cap to replace found stone and 3/4" iron pipe 0.2' west & 0.1' south of high point of stone. This position not established by original government surveyors.
This monument is accepted as the best available evidence of the position of the corner. Witnesses:
South 83° East 28.25 feet set nail & shiner in south face of 6" Oak
West 0.30 feet to found 3/4" reference iron pipe
North 0.40 feet to south edge of steel post
South 89°04'15" West 2624.78 feet to brass remonumentation cap on 1" pipe inside monument box for K-2
South 00°32'17" East 2644.85 feet to brass remonumentation cap on 2" pipe in center of pavement for J-3
North 00°42'22" West 2651.08 feet to found railroad spike (LCRC, L.3, P.328) for J-1

Signed by [Signature]
Surveyor's Michigan License No. 19474

Date 8/22/1996

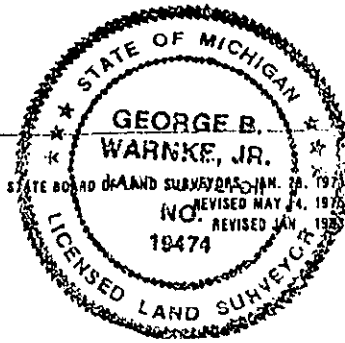

G.B. WARNKE CORNER