

SURVEY & REMONUMENTATION

DEC 16 1996

COMMISSION

LAND CORNER RECORDATION CERTIFICATE
Filing Requirement of Act 74, Mich. P.A. 1970

RECEIVED FOR RECORD

96 NOV 12 AM 8:35

Teri Allen
REGISTER OF DEEDS
MONROE COUNTY, MICH

For corners in

MONROE (58)
(County)

Located In:

Corner Code #

- | | | | | | |
|------------------------------------|---|-------|---|-------|-------|
| 1. Public Land Survey | T | _____ | R | _____ | _____ |
| | T | _____ | R | _____ | _____ |
| BEDFORD TWP. | T | 8S | R | 7E | M 5 |
| | T | _____ | R | _____ | _____ |
| 2. Property Controlling in Section | S | _____ | T | _____ | _____ |
| | S | _____ | T | _____ | _____ |
| 3. Miscellaneous Property in Sec. | S | _____ | T | _____ | _____ |
| | S | _____ | T | _____ | _____ |

Register of Deeds Stamp & File Number

4. Lot No. _____, Recorded Plat _____
5. Private Claims _____

1996 REMONUMENTATION PROGRAM

I, G.B. WARNKE, JR., in a field survey on 1996, 19 _____, do hereby certify that under requirements of P.A. 74, Michigan P.A. of 1970, the corner points mentioned in lines 1 and 2 above were in conformance with regulations and rules therefore as required in the current manual of survey instructions of the United States Department of the Interior, Bureau of Land Management or by a decree of a Court of Law and/or that the corner points mentioned in lines 3, 4 and 5 above were in conformance with the rules of the Michigan Board of Land Surveyors or by a Decree of a Court of Law; established, re-established, monumented, re-monumented, recovered, found as expressed below:

NOTE: Not more than 4 corners, all in the same town and range, may be recorded on this certificate.

	A	B	C	D	E	F	G	H	I	J	K	L
2	6		5		4		3		2		1	
3												
4	7		8		9		10		11		12	
5												
6	18		17		16		15		14		13	
7												
8	19		20		21		22		23		24	
9												
10	30		29		28		27		26		25	
11												
12	31		32		33		34		35		36	
13												

A. Description of original monument and accessories and/or subsequent restoration:

Section Corner common to Sections 7 & 18 / On Erie & Minx Roads (tarby) / common to A-5, T8S, R8E, Erie Twp. 1820, GLO Surveyor, J. Wampler, set post cor. of Secs. 12 & 13 - witnesses: B. Oak 16 S.70E. 19 lks & B. Oak 7 S.60W. 7 lks; 1942, A.J. Marino notes BOLT FOUND; 1954, Case & Fleck note R.R. SPIKE; 1957, A.J. Marino notes R.R. SPIKE; 1973, M.R. Fleck (L.657, P.46 & L.654, P.278) used F.R.R. SPK. (2 witnesses are similar to LCRC witnesses); 1973, G.B. Warnke notes FD. BOLT (2 witnesses are similar to Case & Fleck 1973 witnesses). 1976 & 1978 & 1986, G.B. Warnke notes IRON PIN/ROD; 1973, LCRC by Frank Moskos notes FOUND IRON. (2 witnesses close to Case & Fleck witnesses). 1995, G.B. Warnke found 5/8" iron rod for A-5.

B. Description of corner evidence found and/or method applied in restoring or reestablishing corner:


12/4/1995, G.B. Warnke crew found 5/8 inch iron rod (based on iron found by Case & Fleck in 1979 & by G.B. Warnke in 1995) and witnesses to objects which appear to be still present the 5/8 inch iron rod, which replaced found railroad spike in 1975, is 3.34 feet northeast of an A.J. Marino nail set in 1973. G.B. Warnke had no metallic reading in area of where nail was to have been placed.
4/9/96 - corner approved at Peer Group Remonumentation Meeting.
8/96 - Warnke crew set 1" x 36" iron pipe with brass remon. cap in monument box to replace 5/8" iron rod.

C. Description of monument for corner and accessories established to perpetuate locating the position of the corner:

Set 1" x 36" iron pipe with brass remon. cap in monument box to replace found 5/8 inch iron rod and is accepted as the best available evidence of the position of the original corner and witnessed:
North 35° West 34.68 feet to nail/shiner in southeast face of power pole
North 37° East 78.90 feet to set nail/shiner in west face of 24 inch Cherry tree
North 49° East 41.60 feet to 1/2 inch iron rod
South 44° West 34.92 feet to nail/shiner in east face power pole

RATIFIED BY PEER GROUP
PA 345 OF 1990
MONROE COUNTY, MICHIGAN
date: 4/9/96
County Rep.: [Signature]

Signed by [Signature]
Surveyor's Michigan License No. _____
1996 Remonumentation Corner

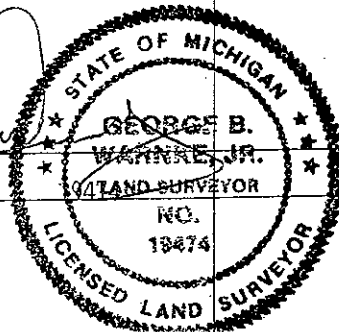

Date 10/10/1996