

**SURVEY &
REMONUMENTATION**

RATIFIED BY PEER GROUP
PA 345 OF 1990
MONROE COUNTY MICHIGAN

DEC 07 1994

RECEIVED FOR RECORD

date: 11/16/1993
County Rep: [Signature]

LAND CORNER RECORDATION CERTIFICATE
Filing Requirement of Act 74, Mich. P.A. 1970

94 OCT 12 PM 2:19

Hari Allen
REGISTER OF DEEDS
MONROE COUNTY, MICH

For corners in

<u>MONROE</u> (County)	Located In:	Corner Code =#
	BEDFORD TWP.	
1. Public Land Survey	T <u>8 S</u> R <u>7 E</u>	<u>M-7</u>
	T _____ R _____	_____
	T _____ R _____	_____
	T _____ R _____	_____
2. Property Controlling in Section	S _____ T _____ R _____	_____
	S _____ T _____ R _____	_____
3. Miscellaneous Property in Sec.	S _____ T _____ R _____	_____
	S _____ T _____ R _____	_____

Register of Deeds Stamp & File Number

4. Lot No. _____, Recorded Plat _____
5. Private Claims _____
1993 MONROE COUNTY REMONUMENTATION PROGRAM
Peer Group approved corner on 11/16/1993 per Act 345 of 1990.

	A	B	C	D	E	F	G	H	I	J	K	L	M
2	6	5	4	3	2	1							
3													
4	7	8	9	10	11	12							
5													
6	18	17	16	15	14	13							
7													
8	19	20	21	22	23	24							
9													
10	30	29	28	27	26	25							
11													
12	31	32	33	34	35	36							
13													

I, G.B. WARNKE, JR., in a field survey on 8/30/1994, 19____, do hereby certify that under requirements of P.A. 74, Michigan P.A. of 1970, the corner points mentioned in lines 1 and 2 above were in conformance with regulations and rules therefore as required in the current manual of survey instructions of the United States Department of the Interior, Bureau of Land Management or by a decree of a Court of Law and/or that the corner points mentioned in lines 3, 4 and 5 above were in conformance with the rules of the Michigan Board of Land Surveyors or by a Decree of a Court of Law; established, re-established, monumented, re-monumented, recovered, found as expressed below:

NOTE: Not more than 4 corners, all in the same town and range, may be recorded on this certificate.

A. Description of original monument and accessories and/or subsequent restoration:


M-7, T8S, R7E, Corner Common to Sections 13 & 24
(At Temperance & Minx Roads)
1820, G.L.O. Surveyor Joseph Wampler set post on east range line between Sections 13 & 24. Witnesses: B. Oak 14 inch S.74°E. 65 links. & Ash 11 inch S.47°W. 58 links. / Surveyors have used the corner since atleast 1972 with no apparent dispute. / G.B. Warnke excavated ~~are~~ in October of 1973 and found R.R. spike over stone.

B. Description of corner evidence found and/or method applied in restoring or reestablishing corner:

M-7 - 11/08/1993, Found Railroad Spike Over Stone and witnessed as shown below.
8/30/1994, replaced points with set 1 inch x 36 inch black iron pipe with brass remonumentation cap inside monument box.

C. Description of monument for corner and accessories established to perpetuate locating the position of the corner:

M-7 - Set 1 inch x 36 inch black iron pipe with brass remonumentation cap inside monument box to replace railroad spike over stone & is accepted as the best available evidence of the position of the original corner & Witnesses:
South 39° West 43.58' U.S.G.S. brass plate (TT-1L? - cannot read clearly) on "+" in triangle (leaning to northwest)
South 44° West 39.31' found nail/aluminum shiner in northeast face of telephone pole
North 36° West 44.10' nail/shiner in southeast face of telephone pole
North 45° West 47.44' found 3/4 inch iron pipe in west bank of road ditch
North 60° East 100.29' found nail/shiner in southwest face of telephone pole

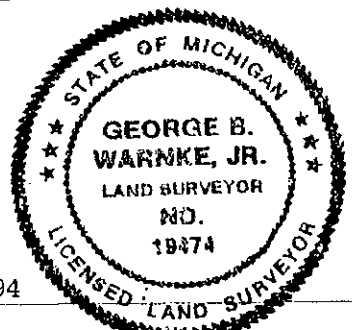

Signed by [Signature] Date 8/30/1994
Surveyor's Michigan License No. 19474