

**SURVEY &
REMONUMENTATION**

DEC 1 8 1996

COMMISSION LAND CORNER RECORDATION CERTIFICATE
Filing Requirement of Act 74, Mich. P.A. 1970

RECEIVED FOR RECORD
96 NOV 12 AM 8:37

For corners in

MONROE
(County)

Located In:

Corner Code #

- | | | | | | |
|-------------------------|---|-----------|---|-----------|------------|
| 1. Public Land Survey | T | _____ | R | _____ | _____ |
| | T | _____ | R | _____ | _____ |
| ERIE TWP. | T | <u>8S</u> | R | <u>8E</u> | <u>A-5</u> |
| | T | _____ | R | _____ | _____ |
| 2. Property Controlling | S | _____ | T | _____ | _____ |
| in Section | S | _____ | T | _____ | _____ |
| 3. Miscellaneous | S | _____ | T | _____ | _____ |
| Property in Sec. | S | _____ | T | _____ | _____ |

Keri Allen
REGISTER OF DEEDS
MONROE COUNTY, MICH

Register of Deeds Stamp & File Number

4. Lot No. _____, Recorded Plat _____
5. Private Claims _____

	A	B	C	D	E	F	G	H	I	J	K	L	M
2	6		5		4		3		2		1		
3													
4	7		8		9		10		11		12		
5													
6	18		17		16		15		14		13		
7													
8	19		20		21		22		23		24		
9													
10	30		29		28		27		26		25		
11													
12	31		32		33		34		35		36		
13													

G.B. WARNKE, JR. - 1996 CORNER

I, G.B. WARNKE, JR. in a field survey on 12/4/1995 - 1996, 19 _____ do hereby certify that under requirements of P.A. 74, Michigan P.A. of 1970, the corner points mentioned in lines 1 and 2 above were in conformance with regulations and rules therefore as required in the current manual of survey instructions of the United States Department of the Interior, Bureau of Land Management or by a decree of a Court of Law and/or that the corner points mentioned in lines 3, 4 and 5 above were in conformance with the rules of the Michigan Board of Land Surveyors or by a Decree of a Court of Law; established, re-established, monumented, re-monumented, recovered, found as expressed below:

NOTE: Not more than 4 corners, all in the same town and range, may be recorded on this certificate.

A. Description of original monument and accessories and/or subsequent restoration:

At Erie & Minx Roads (tarby) / Common to M-5, T8S, R7E, Bedford Township
1820, GLO Surveyor, Joseph Wampler, set post at corner and witnessed: B. Oak 16" S70°E 19 lks; B. Oak 7" S60°W 7 lks; May 1885, Willis Baldwin found stone and witnessed: Willow 10" S53°W 60 lks; Oct 1904, L.A. Howard found stone mostly out of ground but firm, sunk it below surface; A.J. Marino field notes dated March 1954, Dec. 1955 & 1956, June 1967 & 1971 found R.R. spike; A.J. Marino field notes April 1973 shows nail was set at SW corner of Section 7 (8/8); L.C.R.C., L.1, Pg.313 by James T. Bauer notes found R.R. spike; Oct. 1973, Case & Fleck survey (L.657, Pg.46) notes found R.R. spike; Sept. 1975, G.B. Warnke (Job #75-79) notes found R.R. spike, (also found an inverted 2-1/2" by 5/8" bolt - 0.6 feet south & 1.5 feet east - witness ties from L.C.R.C. (L.1, Pg.313) may have used bolt) checked and determined that spike was used for Erie Height Manor Subdivision replaced spike with 5/8" iron rod; June 1979, Case & Fleck survey notes found I.P. (witnesses similar to G.B. Warnke's 1975 survey);

B. Description of corner evidence found and/or method applied in restoring or reestablishing corner:


December 4, 1995, G.B. Warnke crew found 5/8 inch iron rod (based on iron found by Case & Fleck in 1979 & by G.B. Warnke in 1995) and witnesses to objects which appear to be still present the 5/8 inch iron rod, which replaced found railroad spike in 1975, is 3.34 feet northeast of an A.J. Marino nail set in 1973. G.B. Warnke had no metallic reading in area of where nail was to have been placed.
4/9/96 - corner approved at Peer Group Remonumentation Meeting.
8/96 - Warnke crew set 1" x 36" iron pipe with brass remon. cap in monument box to replace 5/8" iron rod.

C. Description of monument for corner and accessories established to perpetuate locating the position of the corner:

Set 1" x 36" iron pipe with brass remonumentation cap inside monument box to replace found 5/8 inch iron rod and is accepted as the best available evidence of the position of the original corner and witnessed:
North 35° West 34.68 feet to nail/shiner in southeast face of power pole
North 37° East 78.90 feet to set nail/shiner in west face of 24 inch Cherry Tree
North 49° East 41.60 feet to 1/2 inch iron rod
South 44° West 34.92 feet to nail/shiner in east face power pole

RATIFIED BY PEER GROUP
PA 345 OF 1990
MONROE COUNTY, MICHIGAN
date: 4/9/1996
County Rep.: [Signature]

Signed by [Signature]
Surveyor's Michigan License No. 19474
G.B. WARNKE - 1996 CORNER (Ref 95-015)

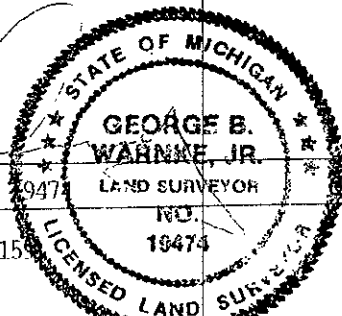

Date 10/10/1996