

SURVEY & REMONUMENTATION

FEB 13 1998

RECEIVED FOR RECORD

97 NOV 12 PM 1:57

SECTION

LAND CORNER RECORDATION CERTIFICATE
Filing Requirement of Act 74, Mich. P.A., 1970

Mari Allen
REGISTER OF DEEDS
MONROE COUNTY, MICH

For corners in

<u>Monroe</u>	Located In:	Corner Code #
(County)	<u>Erie Twp.</u>	<u>A-6</u>
1. Public Land Survey	T <u>8S</u> R <u>8E</u>	<u> </u>
	T <u> </u> R <u> </u>	<u> </u>
	T <u> </u> R <u> </u>	<u> </u>
	T <u> </u> R <u> </u>	<u> </u>
2. Property Controlling in Section	S <u> </u> T <u> </u> R <u> </u>	<u> </u>
	S <u> </u> T <u> </u> R <u> </u>	<u> </u>
3. Miscellaneous Property in Sec.	S <u> </u> T <u> </u> R <u> </u>	<u> </u>
	S <u> </u> T <u> </u> R <u> </u>	<u> </u>
4. Lot No. <u> </u> , Recorded Plat <u> </u>		
5. Private Claims <u> </u>		

Register of Deeds Stamp & File Number

I, George B. Warnke, Jr., in a field survey on July - October, 1997 do hereby state that under requirements of P.A. 74, Michigan P.A. of 1970, the corner points mentioned in lines 1 and 2 above were in conformance with regulations and rules therefore as required in the current manual of survey instructions of the United States Department of the Interior, Bureau of Land Management or by decree of a Court of Law and / or that the corner points mentioned in lines 3, 4 and 5 above were in conformance with the rules of the Michigan Board of Land Surveyors or by a Decree of a Court of Law; established, re-established, monumented, recovered, found as expressed below:

NOTE: Not more than 2 corners, all in the same town and range, may be recorded on this certificate.

1/4 Corner Section 18 at Minx and Half Mile Roads
Remonumentation Program Corner
Corner Common to M-6, T8S, R7E, Bedford Twp.

A	B	C	D	E	F	G	H	I	J	K	L	M
1												
2	6		5		4		3		2		1	
3												
4	7		8		9		10		11		12	
5												
6	18		17		16		15		14		13	
7												
8	19		20		21		22		23		24	
9												
10	30		29		28		27		26		25	
11												
12	31		32		33		34		35		36	
13												

A. Description of original monument and accessories and/or subsequent restoration:

- 1820, GLO Surveyor, Joseph Wampler, worked in T8S, R8E, but did not establish A-6, T8S, R8E
- 1820, GLO Surveyor, Joseph Wampler, notes set qtr. Section post (for M-6, T8S, R7E, Bedford Twp.) - witnesses: W. Oak 16 N 10 E 78 lks / DO 16 S 86 W 102 lks
- 1863, notes by N. Hubble show found stone
- 1885, notes by Willis Baldwin show found stone - witness: R Oak 14 N 33 W 77 1/2
- 1955, A.J. Marino field notes show P. R.R. Spike - witnesses: NW 26.7' Tele pole / SW 19.65' St. sign
- 1975, G.B. Warnke survey (#75-79) shows iron pipe - witnesses: East - 51.52' - West face 8" wood post / S 60° W - 31.69' - E'ly face road sign post / N 45° W - 52.40' - SE cor. of tel. cable box
- 1977, G.B. Warnke survey (#77-118) shows found iron pipe - same witnesses as 1975 Warnke survey (#75-79) with one additional witness: S 65° W - 32.37' - E'ly face yield r/w sign post
- G.B. Warnke LCRC (Liber 2, Page 253) notes iron pipe - same witnesses as 1977 Warnke survey (#77-118)
- 1980, G.B. Warnke survey (#80-120) shows found iron pipe - same witnesses as 1977 Warnke survey (#77-118)
- James A. Fish survey (#1446) shows corner but does not state what was found
- 1981, G.B. Warnke survey (#81-93) shows found iron pipe - same witnesses as 1977 Warnke survey (#77-118)
- 1983, G.B. Warnke survey (#82-71-2) shows 3/4" iron pipe found - witnesses: S 75° W - 46.40' - to face of mailbox post / S 50° E - 65.62' - to SW/s of twin Boxelder / S 55° W - 31.76' - to face of road sign / N 25° W to face of power pole
- 1997, G.B. Warnke remonumentation crew notes found 3/4" pipe

B. Description of corner evidence found and/or method applied in restoring or re-establishing corner:

1997, G.B. Warnke field crew excavated 15' x 18' with backhoe to about 30" depth - nothing found. Used 3/4" x 18" pipe found as best evidence. Reset corner with 1" x 36" iron pipe in gravel road.

RATIFIED BY PEER GROUP, PA 345 OF 1990, MONROE COUNTY, MICHIGAN, DATE 8/26/1997, COUNTY REP *[Signature]*
10/3/1997, set brass remonumentation cap on previously set 1" x 36" iron pipe.

C. Description of monument for corner and accessories established to perpetuate locating the position of the corner:

Set 1" x 36" pipe in gravel road replacing 3/4" x 18" pipe found. This position was not established by original government surveyors. This monument is accepted as the best available evidence of the position of the corner. Witnesses:


- S 76° W - 110.78' - nail in west face of electric pole
- S 47° W - 44.25' - northwest face of electric pole
- N 13° W - 132.15' - nail in easterly face of electric pole
- N 38° W - 52.26' - southeast corner of GTE pedestal
- S 88° E - 51.75' - west face of private drive sign

Signed by

[Signature]

Surveyor's Michigan License No.

19474

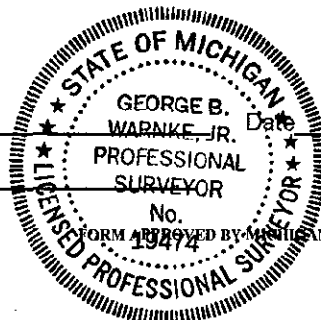

Date 10/8/1997