

RECORDED
 10/10/99
 10/10/99

LAND CORNER RECORDATION CERTIFICATE
Filing Requirement of Act 74, Mich. P.A., 1970

For corners in SECTION
MONROE (58)

Located In: ERIE TWP. Corner Code # B-3

T8S R8E

S T R

S T R

S T R

S T R

4. Lot No. , Recorded Plat

5. Private Claims

RECEIVED FOR RECORD
 99 SEP 30 AM 9:15
George B. Warnke
 REGISTER OF DEEDS
 MONROE COUNTY, MICH.

Register of Deeds Stamp & File Number

1998 & 1999 Remonumentation Program Corner

I, George B. Warnke, Jr., in a field survey on 1998 & 8/16/1999 do hereby state that under requirements of P.A. 74, Michigan P.A. of 1970, the corner points mentioned in lines 1 and 2 above were in conformance with regulations and rules therefore as required in the current manual of survey instructions of the United States Department of the Interior, Bureau of Land Management or by decree of a Court of Law and / or that the corner points mentioned in lines 3, 4 and 5 above were in conformance with the rules of the Michigan Board of Land Surveyors or by a Decree of a Court of Law; established, re-established, monumented, recovered, found as expressed below:
 NOTE: Not more than 2 corners, all in the same town and range, may be recorded on this certificate.


| | | | | | | | | | | | | | |
|----|---|----|---|----|---|----|---|----|---|----|---|----|---|
| 1 | A | B | C | D | E | F | G | H | I | J | K | L | M |
| 2 | | 6 | | 5 | | 4 | | 3 | | 2 | | 1 | |
| 3 | | | | | | | | | | | | | |
| 4 | | 7 | | 8 | | 9 | | 10 | | 11 | | 12 | |
| 5 | | | | | | | | | | | | | |
| 6 | | 18 | | 17 | | 16 | | 15 | | 14 | | 13 | |
| 7 | | | | | | | | | | | | | |
| 8 | | 19 | | 20 | | 21 | | 22 | | 23 | | 24 | |
| 9 | | | | | | | | | | | | | |
| 10 | | 30 | | 29 | | 28 | | 27 | | 26 | | 25 | |
| 11 | | | | | | | | | | | | | |
| 12 | | 31 | | 32 | | 33 | | 34 | | 35 | | 36 | |
| 13 | | | | | | | | | | | | | |

- A. Description of original monument and accessories and/or subsequent restoration:
- 1820 - GLO - Joseph Wampler - set the 1/4 sec. post at average dis. from which a @. Oak 20 ins. dia. bears N69E 36 lks. dis. & an Ash 9 ins. dia. bears S20E 49 lks. dis.
- 1964 - Michigan State Highway Department - Louis Czubak #12581 - witness card - Set Ackerman Bolt - witnesses:
 N48°W 98.19' S.E. Cor. Church sign base
 N38°E 38.03' T.P.
 S45°W 39.52' P.P.
 S54°E 61.47' 21" Elm
- 1973 - M.R. Fleck - LCRC, Liber 1, Page 351 - Mon. Box found - witnesses:
 N38°E 38.03' to nail in T. Pole
 N48°W 98.19' to SE. Cor. of church sign
 S45°W 39.52' to nail in P. Pole
- 1975 - Case & Fleck - Survey #18923 - Fd. Mon. Box - witnesses match G.B. Warnke 1980
- 1977 - Case & Fleck - Survey #19705 recorded in Liber 804, Page 288 - Fd. Mon. Box - witnesses match G.B. Warnke 1980
- 1977 - G.B. Warnke - Survey #77-80 recorded in Liber 734, Page 46 & Liber 756, Page 905 - monument box - witnesses match G.B. Warnke 1980
- 1977 - A.J. Marino - field notes - Mon. Box I.R. - no stated witnesses
- 1978 - Case & Fleck - Survey recorded in Liber 762, Page 122 - Mon. Box - witnesses:
 N38°E 38.08' to T. pole
 N45°W 98.19' to SE. cor. sign
 S45°W 39.52' to P. pole
- 1979 - Case & Fleck - Survey recorded in Liber 803, Page 424 - Fd. mon. box - witnesses match G.B. Warnke 1980
- 1980 - G.B. Warnke - Survey #80-42 - monument box - witnesses:
 N40°E 38.03' telephone pole
 N45°W 98.19' SE cor. of church sign
 S45°W 39.52' electric pole
- 1982 - Case & Fleck - Survey #21091-A recorded in Liber 869, Page 899 - Mon. Box rec. L.756, P.905
- 1982 - Case & Fleck - Survey recorded in Liber 869, Page 238 - no material or witnesses noted
- 1988 - G.B. Warnke - Survey #88-703 - Fd. Mon. Box (could not open - used center) - witnesses:
 N50°W 98.82' S.E. cor. church sign
 N45°E 40.88' nail & washer in S.W. face guy pole
 S45°W 38.80' nail & washer in N.E. face elec. pole
 S45°E 39.08' stop sign
- 1988 - Case & Fleck - Survey #21705 - Found Mon. Box - no stated witnesses
- 1992 - G.B. Warnke - LCRC, Liber 3, Page 283 & Survey #92-0503, recorded in Liber 1283, Page 0097 - found monument box with stuck lid & set a chiseled "+" on top center of lid - one witness shown on Case & Fleck survey intact & agrees - witnesses:
 N40°E 40.80' fd. nail/washer S.W. side of guy pole
 S45°W 38.78' fd. nail/washer N.E. side of utility pole
 N45°W 98.26' S.E. corner of church sign base
 N60°W 134.88' S.W. corner of church building
 S40°W 12.48' "+" in station 559+00 in concrete pavement
 South 0.25' center strip of M-151 pavement
- 1997 - G.B. Warnke - witness card - found point in monument box but could not remove lid - got lid off at later date - checked some old witnesses which fit & matches 4 witnesses in 1998
- 1998 - G.B. Warnke - Survey #98-0053 - recorded in Liber 1699, Page 0373 - found 1/4" rod in monument box - witnesses:
 S45°W 38.77' found nail & washer in northeast face utility pole
 N45°E 40.78' found bent nail & washer (straightened) in southwest face guy pole
 N45°W 98.17' southeast corner of concrete base of church worship sign
 N60°W 134.90' southwest corner of "Erie United Methodist" church





FORM APPROVED BY MICHIGAN STATE BOARD OF LAND SURVEYORS, JAN. 28, 1971
 REVISED MAY 14, 1975
 REVISED JAN., 1983
 REVISED OCT., 1994

B. Description of corner evidence found and/or method applied in restoring or re-establishing corner:
Corner is located at the intersection of Lakeside Road / M-151 & Cemetery Road in concrete.
6/16/1999 - found rod in monument box & placed yellow plastic remonumentation cap on rod
RATIFIED BY PEER GROUP, PA 345 OF 1990, MONROE COUNTY, MICHIGAN, DATE 8/18/1998, COUNTY REP.
and is accepted as the best available evidence of the position of the original corner.

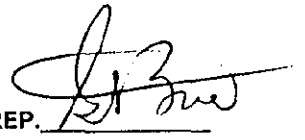

C. Description of monument for corner and accessories established to perpetuate locating the position of the corner:
Set yellow plastic remonumentation cap on existing rod in existing monument box & Witnesses:
South 45° West 38.77 feet to found nail / shiner in northeasterly face of utility pole
North 45° East 40.78 feet to found nail / washer in southwesterly face of guy pole
North 45° West 98.17 feet to southeasterly corner concrete base of church sign
North 60° West 134.90 feet southwesterly corner of Church (Erie United Methodist)

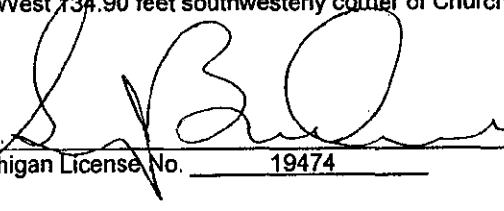Signed by 
Surveyor's Michigan License No. 19474

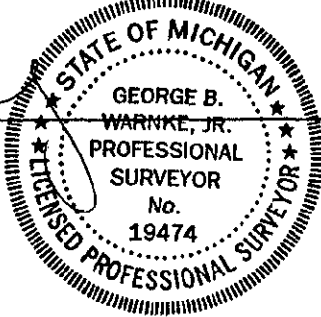

Date June 21, 1999

Page 2 of 2 for B-3, T8S, R8E, Erie Twp., Monroe Co., MI

RE
SECTION