

RATIFIED BY PEER GROUP  
PA 345 OF 1990  
MONROE COUNTY, MICHIGAN

LAND CORNER RECORDATION CERTIFICATE  
Filing Requirement of Act 74, Mich. P.A. 1970

date: 9/26/1995

Corners in Monroe (58)  
(County)

Located In: \_\_\_\_\_ Corner Code # \_\_\_\_\_

- |                                    |                         |            |
|------------------------------------|-------------------------|------------|
| 1. Public Land Survey              | T _____ R _____         | _____      |
| ERIE TWP.                          | T <u>8S</u> R <u>8E</u> | <u>B-7</u> |
|                                    | T _____ R _____         | _____      |
|                                    | T _____ R _____         | _____      |
| 2. Property Controlling in Section | S _____ T _____ R _____ | _____      |
|                                    | S _____ T _____ R _____ | _____      |
| 3. Miscellaneous Property in Sec.  | S _____ T _____ R _____ | _____      |
|                                    | S _____ T _____ R _____ | _____      |

**SURVEY & REMONUMENTATION**

APR 04 1996

Register of Deeds Stamp & File Number

COMMISSION

4. Lot No. \_\_\_\_\_ Recorded Plat \_\_\_\_\_  
5. Private Claims \_\_\_\_\_

1995 Remonumentation Program

I, G.B. WARNKE, JR., in a field survey on July - Sept., 1995, 19 \_\_\_\_\_, do hereby certify that under requirements of P.A. 74, Michigan P.A. of 1970, the corner points mentioned in lines 1 and 2 above were in conformance with regulations and rules therefore as required in the current manual of survey instructions of the United States Department of the Interior, Bureau of Land Management or by a decree of a Court of Law and/or that the corner points mentioned in lines 3, 4 and 5 above were in conformance with the rules of the Michigan Board of Land Surveyors or by a Decree of a Court of Law; established, re-established, monumented, re-monumented, recovered, found as expressed below:

NOTE: Not more than 4 corners, all in the same town and range, may be recorded on this certificate.

	A	B	C	D	E	F	G	H	I	J	K	L
2	6	5	4	3	2							
3												
4	7	8	9	10	11	12						
5												
6	16	17	16	15	14	13						
7	●											
8	19	20	21	22	23	24						
9												
10	30	29	28	27	26	25						
11												
12	31	32	33	34	35	36						
13												

A. Description of original monument and accessories and/or subsequent restoration:

1/4 Corner common to Sections 18 & 19 / On Temperance Road being west of Telegraph Road & east of Minx Road - 3" tar chip surface over 12" mix of stone & clay.  
1820, GLO Surveyor, J. Wampler, set qr. Sec. post post at aver. dist. - witnesses: W. Oak 38 S.10E. 34 lks. & no other bearing tree. 1863, survey by N. Hubble notes Old 1/2 post. May 1885, survey by Willis Baldwin - found 1/4 stone S. side of Sec. (18) remnants of old W. Oak stump there. 12/11/51, A.J. Marino field notes state F. GRANITE STONE. 1972, M.R. Fleck (reference survey, recorded in Liber 636, Page 153) LCRC, recorded in Liber 1, Page 135, notes RR Spike set. 1973, survey by Mannik, Schneider & Assoc. Job.No. 73023, recorded in Liber 647, Page 616, notes R.R. Spike. G.B. Warnke: 1982 LCRC, recorded in Liber 2, Page 474, retraced 1952 Case & Fleck survey and found stone being 8 feet south of RR spike (per LCRC, Ll, P135) and set iron pipe over stone & 1992 survey & 1995 crew notes found iron pipe over stone


B. Description of corner evidence found and/or method applied in restoring or reestablishing corner:

7/1995 - Dug a 20" x 36" hole; found capped (#19474) iron pipe 3" below surface of road; found and removed a 14" x 7" x 7" dark gray granite stone at 23" deep with high point of stone under the pipe; no further evidence found; replaced points with 1" x 36" iron pipe inside monument box and witnessed as shown below.  
9/26/95 - corner was Peer Group approved. 9/29/95 - G.B. Warnke crew set 1" x 36" iron pipe with brass remonumentation cap in monument box to replace stone.

C. Description of monument for corner and accessories established to perpetuate locating the position of the corner:

Set brass remonumentation cap on 1" x 36" iron pipe inside monument box to and is accepted as a careful and faithful perpetuation of the position of the original corner and witnesses:  
North 33.27 feet to found nail/shiner to west face of utility pole  
North 50° East 72.80 feet set nail/shiner in south face of utility pole  
South 70° East 71.83 feet to set nail/shiner in north face of utility pole  
North 75° West 112.72 feet to top centerline of 12" C.M.P.  
West 12.98 feet to projection of east garage wall of residence #1140  
North 05° East 8.23 feet to a found railroad spike

Signed by [Signature] Date 12/19/1995  
Surveyor's Michigan License No. 19474

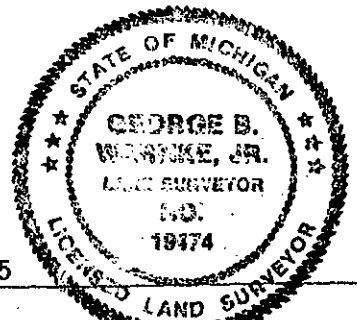

FORM APPROVED BY MICHIGAN STATE BOARD OF LAND SURVEYORS, JAN. 28, 1971  
REVISED MAY 14, 1975  
REVISED JAN., 1983

⑭ B-7 (8/8) Erie

4 PAGE 95