

FEB 13 1998

SECTION

LAND CORNER RECORDATION CERTIFICATE  
Filing Requirement of Act 74, Mich. P.A., 1970

For corners in

MONROE (58)

(County)

Located In:

Corner Code #

ERIE TWP.

T8S R8E

C-3

1. Public Land Survey

T \_\_\_ R \_\_\_

T \_\_\_ R \_\_\_

T \_\_\_ R \_\_\_

T \_\_\_ R \_\_\_

2. Property Controlling in Section

S \_\_\_ T \_\_\_ R \_\_\_

S \_\_\_ T \_\_\_ R \_\_\_

3. Miscellaneous Property in Sec.

S \_\_\_ T \_\_\_ R \_\_\_

S \_\_\_ T \_\_\_ R \_\_\_

RECEIVED FOR RECORD  
97 DEC 30 PM 3:33  
*Henry Wilson*  
REGISTER OF DEEDS  
MONROE COUNTY, MICH.


Register of Deeds Stamp & File Number

4. Lot No. \_\_\_\_\_, Recorded Plat \_\_\_\_\_

5. Private Claims \_\_\_\_\_

1997 REMONUMENTATION PROGRAM CORNER

I, George B. Warnke, Jr., in a field survey on September - October, 1997 do hereby state that under requirements of P.A. 74, Michigan P.A. of 1970, the corner points mentioned in lines 1 and 2 above were in conformance with regulations and rules therefore as required in the current manual of survey instructions of the United States Department of the Interior, Bureau of Land Management or by decree of a Court of Law and / or that the corner points mentioned in lines 3, 4 and 5 above were in conformance with the rules of the Michigan Board of Land Surveyors or by a Decree of a Court of Law; established, re-established, monumented, recovered, found as expressed below:

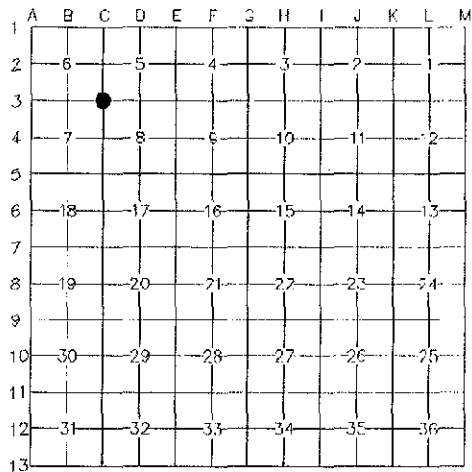

NOTE: Not more than 2 corners, all in the same town and range, may be recorded on this certificate.

A. Description of original monument and accessories and/or subsequent restoration:

1820 GLO, Joseph Wampler - Dep. Surveyor, set post corner of Secs. 5, 6, 7 & 8 from which a W. Oak 22 ins. dia. bears West 45 lks. dis. & a W. Oak 28 ins. dia. bears N18E 50 lks dis.

1950 AJ Marino field notes show Found iron pipe in center of road

1958 AJ Marino field notes show F. Spike

1987 G.B. Warnke recorded LCRC, Liber 3, Page 29, notes iron pin in monument box - witnesses: S50°W 44.95' nail in N.W. face elec. pole / N30°W 70.95' nail (MSHD) in S.W. face guy pole / N30°E 63.00' nail (MSHD) in S.E. face tel. pole / S40°E 60.69' nail in W. face of tel. pole

B. Description of corner evidence found and/or method applied in restoring or re-establishing corner:

9/16/1997, G.B. Warnke crew found iron pin with mushroom top in existing monument box with top missing and checked previous witnesses.

RATIFIED BY PEER GROUP, PA 345 OF 1990, MONROE COUNTY, MICHIGAN, DATE 12/9/1997, COUNTY REP. *[Signature]*

12/12/1997 Set yellow plastic remonumentation cap on found iron pin with mushroom top in existing monument box

C. Description of monument for corner and accessories established to perpetuate locating the position of the corner:

Set yellow plastic remonumentation cap on found iron pin with mushroom top in existing monument box and is accepted as the best available evidence of the position of the original corner. Witnesses:

South 50° West 44.95 feet to nail & car coin in northwest face of electric pole

South 40° East 59.80 feet to PK nail in north face of telephone pole

North 30° East 62.0 feet to set nail & remonumentation shiner in east face of telephone pole

South 45° East 67.02 feet to northeast corner of Smith Farm's sign's north 4" x 4" post

North 15° West 47.56 feet to northwest edge of west post of "Stop" sign at northwest corner of Strasburg Road & Lakeside Road

Signed by

*[Signature]*

Date December 17, 1997

Surveyor's Michigan License No.

19474



FORM APPROVED BY MICHIGAN STATE BOARD OF LAND SURVEYORS, JAN. 28, 1971  
REVISED MAY 14, 1975  
REVISED JAN., 1983  
REVISED OCT. 1994