

SURVEY & REMONUMENTATION

DEC 16 1996

COMMISSION

LAND CORNER RECORDATION CERTIFICATE
 Filing Requirement of Act 74, Mich. P.A. 1970

RECEIVED FOR RECORD
 96 NOV 12 AM 8:38

For corners in

MONROE (58)
 (County)

Located In:

Corner Code #

- 1. Public Land Survey T _____ R _____
 T _____ R _____
 ERIE TOWNSHIP T 8S R 8E
 T _____ R _____
- 2. Property Controlling S _____ T _____ R _____
 in Section S _____ T _____ R _____
- 3. Miscellaneous S _____ T _____ R _____
 Property in Sec. S _____ T _____ R _____

C-5

Peri Allen
 REGISTER OF DEEDS
 MONROE COUNTY, MICH

Register of Deeds Stamp & File Number

- 4. Lot No. _____, Recorded Plat _____
- 5. Private Claims _____

GEORGE B. WARNKE, JR. - 1996 CORNER

I, G.B. WARNKE, JR. in a field survey on 1995 & 1996, 19_____, do hereby certify that under requirements of P.A. 74, Michigan P.A. of 1970, the corner points mentioned in lines 1 and 2 above were in conformance with regulations and rules therefore as required in the current manual of survey instructions of the United States Department of the Interior, Bureau of Land Management or by a decree of a Court of Law and/or that the corner points mentioned in lines 3, 4 and 5 above were in conformance with the rules of the Michigan Board of Land Surveyors or by a Decree of a Court of Law; established, re-established, monumented, re-monumented, recovered, found as expressed below:

NOTE: Not more than 4 corners, all in the same town and range, may be recorded on this certificate.

	A	B	C	D	E	F	G	H	I	J	K	L	M
2	6		5		4		3		2		1		
3													
4	7		8		9		10		11		12		
5													
6	18		17		16		15		14		13		
7													
8	19		20		21		22		23		24		
9													
10	30		29		28		27		26		25		
11													
12	31		32		33		34		35		36		
13													

A. Description of original monument and accessories and/or subsequent restoration:

Section Corner common to Sections 7, 8, 17 & 18 / At Erie & Strasburg Roads - surface being 3" asphalt over 24" heavy stone over 6" black clay? with pieces of clay tile / pavement appears to be about as 2' above grade. 1847, GLO Surveyor, Orange Risdon, set post cor. of Secs. 7, 8, 17 & 18 - witnesses: W. Oak 20 (inch) S.22E. lks. & W. Oak 22 (inch) N.82E. 51 lks. May 1885, Willis Baldwin notes STONE. Aug. 1947, O.A. Case used corner but did not note material. 1955, 58, 62, 63, 65, 66, 71 & 1978 - A.J. Marino found railroad spike. 1988, 1990, 1994 & 1995, G.B. Warnke used railroad spike and set/found nail & washer over spike.

B. Description of corner evidence found and/or method applied in restoring or reestablishing corner:


10/14/1995 - Warnke crew found nail & shiner (at surface) over railroad spike (3" deep). No other evidence was found.
 4/9/96 - Corner approved at Peer Group Remonumentation Meeting.
 8/29/96 - Warnke crew found concrete nail & washer over railroad spike being 3" deep. Excavated down approximately 3' & probed another 3' - no further evidence found. Set heavy stones, being 4-5" diameter, around bottom of set 1" x 36" iron pipe with brass remonumentation cap inside monument box to replace nail & shiner over railroad spike.

C. Description of monument for corner and accessories established to perpetuate locating the position of the corner:

Set 1" x 36" iron pipe with brass remonumentation cap inside monument box to replace found nail & shiner over railroad spike and is accepted as the best available evidence of the position of the original corner and witnesses:
 North 50° West 53.70 feet to northeast corner of east wing wall
 South 25° East 40.17 feet to found nail & shiner in north face of telephone pole
 South 20° West 27.75 feet to southeast corner of east wing wall
 North 50° East 107.04 feet to top nut of hydrant

RATIFIED BY PEER GROUP
 PA 345 OF 90
 MONROE COUNTY MICHIGAN
 date: 4/9/1996
 County Rep.: [Signature]

Signed by _____
 Surveyor's Michigan License No. _____
 1996 - G.B. WARNKE CORNER

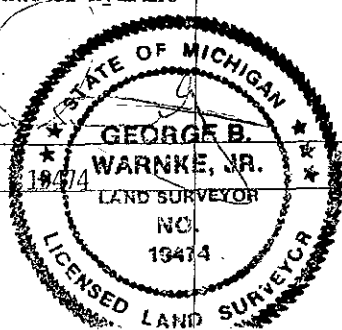

Date 10/10/1996

FORM APPROVED BY MICHIGAN STATE BOARD OF LAND SURVEYORS, JAN. 28, 1971
 REVISED MAY 14, 1975
 REVISED JAN., 1983