

SURVEY & REMONUMENTATION

FEB 13 1998

SECTION

LAND CORNER RECORDATION CERTIFICATE
Filing Requirement of Act 74, Mich. P.A., 1970

For corners in

MONROE (58)
 (County)

Located In:

Corner Code #

	ERIE TWP.	
1. Public Land Survey	T <u>8S</u> R <u>8E</u>	<u>D-3</u>
	T _____ R _____	_____
	T _____ R _____	_____
	T _____ R _____	_____
2. Property Controlling in Section	S _____ T _____ R _____	_____
	S _____ T _____ R _____	_____
3. Miscellaneous Property in Sec.	S _____ T _____ R _____	_____
	S _____ T _____ R _____	_____

RECEIVED FOR RECORD
 97 DEC 30 PM 3:36
George B. Warnke
 REGISTER OF DEEDS
 MONROE COUNTY, MICH.


Register of Deeds Stamp & File Number

4. Lot No. _____, Recorded Plat _____

5. Private Claims _____

1997 REMONUMENTATION PROGRAM CORNER

I, George B. Warnke, Jr., in a field survey on September - December, 1997 do hereby state that under requirements of P.A. 74, Michigan P.A. of 1970, the corner points mentioned in lines 1 and 2 above were in conformance with regulations and rules therefore as required in the current manual of survey instructions of the United States Department of the Interior, Bureau of Land Management or by decree of a Court of Law and / or that the corner points mentioned in lines 3, 4 and 5 above were in conformance with the rules of the Michigan Board of Land Surveyors or by a Decree of a Court of Law; established, re-established, monumented, recovered, found as expressed below:

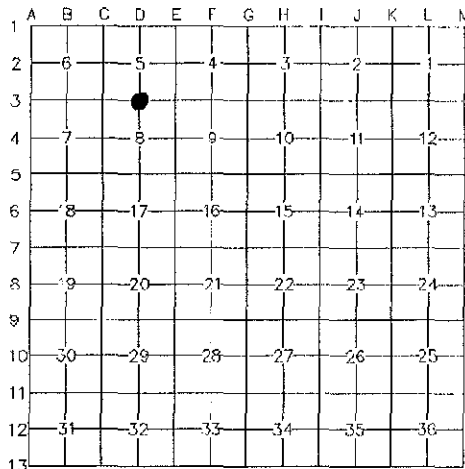

NOTE: Not more than 2 corners, all in the same town and range, may be recorded on this certificate.

A. Description of original monument and accessories and/or subsequent restoration:

- 1820 G.L.O. Joseph Wampler, Corrected the line between Secs. No. 5 & 8 - Set the 1/4 sec. Post at average dis. from which a W. Oak 14 ins. dia. bears S63E 26 lks. dis. & a B. Oak 20 ins. dia. bears N4W 24 lks. dis.
- 1950 A.J. Marino notes - Found I.P.
- 1964 Michigan State Highway Department, Louis Czubak, witness card - Found 3/4" pipe - Witnesses: N55W 56.61' to a P.P. & S60W 66.35' to a 43" Box Elder & S15E 41.89' to a 18" Ash
- 1968 Case & Fleck Survey - used corner - no material noted
- 1970 A.J. Marino notes - Mon.
- 1980 G.B. Warnke Survey #80-132 - Iron Pin in Monument Box
- 1989 G.B. Warnke LCRC, Liber 3, Page 56 - Iron Pin in Monument Box - Witnesses: S30°W 35.73' Found M.S.H.D. tag in east face Elec. Pole & North 31.25' Found nail & shiner South face Tele. Pole & N55°W 56.60' Found M.S.H.D. tag in East face Tele. Pole & N40°W 72.00' South face 15" Blue Spruce
- 1993 G.B. Warnke Survey #93-0007 - Found Iron Pin in Monument Box - witnesses same as 1989 LCRC
- 1997 Lori Beyer LCRC, Liber 4, Page 260 - boat spike in monument box - witnesses: N55°W 56.58' to MSHD tag in E. face of Power Pole & N05°W 31.35' to nail & shiner in S. face of Power Pole & S15°W 35.74' to MSHD tag in E. face of Power Pole

B. Description of corner evidence found and/or method applied in restoring or re-establishing corner:

9/26/1997, G.B. Warnke found boat spike in concrete inside monument box in Lakeside Road being +/- 1/4 mile west of Telegraph Road. Checked witnesses - see witnesses below.

RATIFIED BY PEER GROUP, PA 345 OF 1990, MONROE COUNTY, MICHIGAN, DATE 12/9/1997, COUNTY REP. *[Signature]*

12/12/1997, Wired on plastic remonumentation cap to found boat spike in concrete inside monument box.

C. Description of monument for corner and accessories established to perpetuate locating the position of the corner:

Wired on plastic remonumentation cap to found boat spike in concrete inside monument box and is accepted as the best available evidence of the position of the original corner. Witnesses:
 North 55° West 56.60 feet to M.S.H.D. tag & nail in northeasterly face of telephone pole
 North 30.12 feet to nail & shiner found in southerly face of telephone pole
 South 30° West 35.75 feet to M.S.H.D. tag & nail in easterly face of electric pole
 North 40° West 72.00 feet to nail & brass tag in southerly face of 18" Spruce

Signed by *[Signature]*
 Surveyor's Michigan License No. 19474

Date December 16, 1997

